

CERTIFIED RECORD OF LAND CORNER MONUMENTATION


History of original corner establishment:

Corner established by Gordon C. Smith, under instructions dated January 13, 1940, for mineral survey #867

Set a 1" x 36" galvanized iron pipe 28" in ground marked "C24-NY3-867 BT", from which;

a pine 6" in diameter bears S19°E. a distance of 9.5 ft., marked "C24-NY3-867 BT"

a pine 6" in diameter bears N25°W a distance of 15.5 ft., marked "C24-Ny3-867 BT"

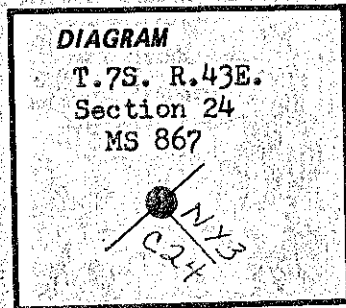

Description of corner evidence found:

Found 1" galvanized iron pipe marked "NY3 867 C2"

Bearing tree;


14" ponderosa pine - S19°E - 9.5 ft. healed face.
NW BT gone.

Distances to side and center of BT's

Description of monument and accessories established to perpetuate the original location of this corner:

Set 2 1/2" x 30" aluminum pipe with 3/4" aluminum cap 24" in ground in mound of stone, marked;

Buried original pipe alongside new monument.

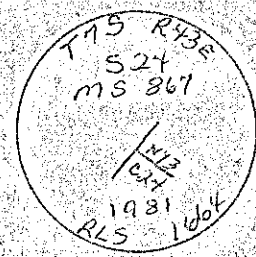

Bearing tree;

11" ponderosa pine - N30°E - 39.8 ft. scribed "NY3-C24 MS 867" in upper blaze and "BT" and brass tag stamped RLS 1664 in lower blaze.

Compass declination 20°East

Note:

I set a steel fence post with USFS Attention sign at corner, placed USFS 54-8 signs on all bearing trees and painted red band on smoothed bark at breast height on all bearing trees.

I hereby certify the above corner location as perpetuated as herein described October 27, 1981.

Terry Butler Terry Butler, Witness

Frank Vaughn Frank Vaughn, Witness

Office of..... County of.....
 State of..... I hereby certify that the within instrument was filed in this office
 for record on the..... day of....., 19.....

(COUNTY OFFICIAL)

(DEPUTY)

REGISTERED
PROFESSIONAL
LAND SURVEYOR

Carl E. Sundet
OREGON
JULY 14, 1973
CARL E. SUNDET
1664

FILED Nov. 9, 1981

BAKER COUNTY SURVEYOR

SURVEY NO. 7-43-40