

CERTIFIED RECORD OF LAND CORNER MONUMENTATION


History of original corner establishment:

Corner established by Gordon C. Smith under instructions dated January 13, 1940, for mineral survey #867.

Set a 1" x 36" galvanized iron pipe 28" in ground marked "E3-C3-867" from which;

a fir 8" in diameter bears N11°W a distance of 44.3 ft., marked "E3-C3-867 BT"

a tamarack 16" in diameter bears N54°W a distance of 28.2 ft., marked "E3-C3-867 BT"

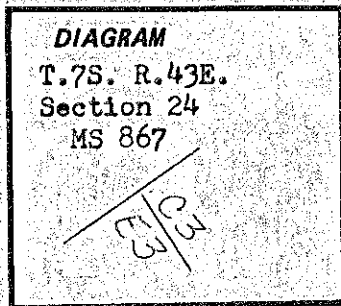

Description of corner evidence found:

Found no evidence of original pipe.

Bearing tree;

15" tamarack - out of position - dead and down scribed "E3-C3 8"

Description of monument and accessories established to perpetuate the original location of this corner:


Set 2 1/2" x 30" aluminum pipe with 3 1/4" aluminum cap 26" in ground in mound of stone, marked:

Bearing trees;

10" white fir - N18°E - 55.6 ft. - scribed "C3-E3 MS" in upper blaze and "BT" and brass tag stamped RLS 1664 in lower blaze.

14" ponderosa pine - N68°E - 59.3 ft. - scribed "C3-E3-MS 867" in upper blaze and "BT" and brass tag stamped RLS 1664 in lower blaze.

Compass declination 20° East

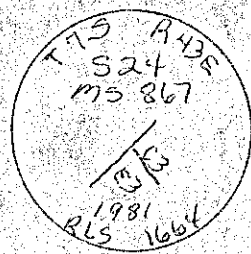

Note:

I set a steel fence post with USFS attention sign at corner, placed USFS 54-8 signs on all bearing trees and painted red band on smoothed bark at breast height on all bearing trees.

I hereby certify the above corner location was perpetuated as herein described in October 1981.

Terry Butler Terry Butler, Witness

Frank Vaughn Frank Vaughn, Witness

REGISTERED PROFESSIONAL LAND SURVEYOR

Carl E. Sundet

OREGON JULY 14, 1978 CARL E. SUNDET 1664

Office of..... County of..... State of..... I hereby certify that the within instrument was filed in this office for record on the..... day of....., 19..... by..... (COUNTY OFFICIAL) (DEPUTY)