

CERTIFIED RECORD OF LAND CORNER MONUMENTATION


History of original corner establishment:

Corner established by Gordon C. Smith under instructions dated January 13, 1940, for mineral survey #867.

Set a 1" x 36" galvanized iron pipe 28" in ground marked "E1-S2-02-867" from which;

a fir 6" in diameter bears N49°E a distance of 17.3 ft., marked "E1-S2-02-867 BT"

a fir 6" in diameter bears N72°W a distance of 13.5 ft., marked "E1-S2-02-867 BT"

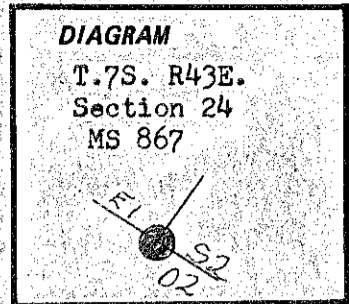

Description of corner evidence found:

Found 1" galvanized iron pipe marked "S2-02-E1 867"

Bearing trees;

14" fir - N70°W - 13.5 ft. - healed face - no visible scribing.


17" fir - N53½°E - 17.1 ft. - healed face. No scribing

Distances to center of BT's

Description of monument and accessories I established to perpetuate the original location of this corner:

Set 2½" x 30" aluminum pipe with ¾" aluminum cap 24" in ground in mound of stone, marked;

Buried original pipe alongside new monument.

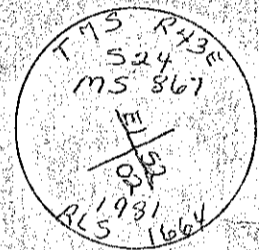

Note:

I set a steel fence post with USFS attention sign at corner, placed USFS 54-8 signs on all bearing trees and painted red band on smoothed bark at breast height on all bearing trees.

I hereby certify the above corner location was perpetuated as herein described October 27, 1981.

Terry Butler Terry Butler, Witness

Frank Vaughn Frank Vaughn, Witness



Office of..... County of.....  
 State of....., I hereby certify that the within instrument was filed in this office  
 for record on the..... day of....., 19.....  
 by.....  
 (COUNTY OFFICIAL) (DEPUTY)