

CERTIFIED RECORD OF LAND CORNER MONUMENTATION


History of original corner establishment:

Corner established by Gordon C. Smith; under instructions dated January 13, 1940, for mineral survey #867

Set 1" x 36" galvanized iron pipe, 28" in ground marked "S4-G2-V2-E3-867 from which;

A fir 10" in diameter bears N36°E, a distance of 41 ft., marked "S4-G2-V2-E3-867 BT"

A fir 10" in diameter bears N51°E a distance of 36.5 ft. marked "S4-G2-V2-E3-867 BT"

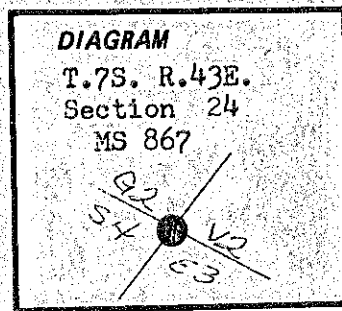

Description of corner evidence found:

Found 1" galvanized iron pipe marked "G2-S4-E3-V2-867 "

Bearing trees;

8" fir - N56°E - 37.2 ft. - stump/log alongside scribed "V2-E3-S4-G2 867 BT"


7" fir - N41°E - 41.2 ft. - dead and down - scribing illegible

Distances to side & center of BT's

Description of monument and accessories established to perpetuate the original location of this corner:

Set 2½" x 30" aluminum pipe with ¾" aluminum cap 24" in ground in mound of stone, marked;

Buried original pipe alongside of new monument

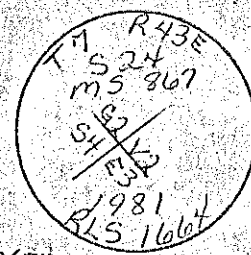

Bearing trees;

7" ponderosa pine - S47°W - 20.9 ft. - scribed "V2-G2-E3-S4 MS 867" in upper blaze and "BT" and brass tag stamped RLS 1664 in lower blaze.

9" ponderosa pine - S37½°E - 33.2 ft. - scribed "V2-G2-E3-S4 MS 867" in upper blaze and "BT" and brass tag stamped RLS 1664 in lower blaze.

Compass declination 20° East

Note:

I set a steel fence post with USFS Attention sign at corner, placed USFS 54-8 signs on all bearing trees, and painted red band on smooth bark at breast height on all bearing trees.

I hereby certify the above corner location was perpetuated as herein described October 27, 1981.

Terry Butler
Frank Vaughn

Terry Butler, Witness

Frank Vaughn, Witness

REGISTERED
 PROFESSIONAL
 LAND SURVEYOR

Carl E. Sundet

OREGON
 JULY 14, 1978
 CARL E. SUNDET
 1664

Office of..... County of.....

State of..... I hereby certify that the within instrument was filed in this office for record on the..... day of....., 19.....

(COUNTY OFFICIAL)

(DEPUTY)

Form R6-7100-57 (9/71)

FILED Nov. 9, 1981
 BAKER COUNTY SURVEYOR
 SURVEY NO. 7-43-43