

CERTIFIED RECORD OF LAND CORNER MONUMENTATION


History of original corner establishment:

Corner established by Gordon C. Smith, under instructions dated January 13, 1940, for mineral survey #867.

Set 1" x 36" galvanized iron pipe 28" in ground marked "C4-C23-867" from which;

a pine 12" in diameter bears S38°W a distance of 3.5 ft., marked "C4-C23-867 BT"

a pine 12" in diameter bears N13°E a distance of 8.5 ft., marked "C4-C23-867 BT"

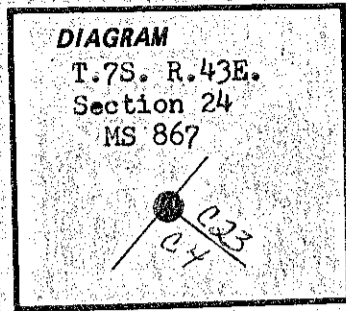

Description of corner evidence found:

Found 1" galvanized iron pipe 2" above ground.

Bearing tree;

10" ponderosa pine - a 5ft. snag - N17°E - 8.5 ft. to face.


Scribed "C4-C23 867 BT"

Root hole S38°W - 3.5 ft., tree is gone

Description of monument and accessories established to perpetuate the original location of this corner:

Set 2 1/2" x 30" aluminum pipe with 3 1/4" aluminum cap 26" in ground in mound of stone, marked;

Buried original pipe alongside new monument.

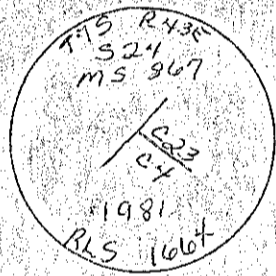

Bearing trees;

6" ponderosa pine - S78°W - 15.1 ft. - scribed "C4-C23 MS 867" in upper blaze and "BT" and brass tag stamped RLS 1664 in lower blaze

10" ponderosa pine - S29°W - 42.5 ft. - scribed "C4-C23 MS 867" in upper blaze and "BT" and brass tag stamped RLS 1664 in lower blaze

Compass declination 20° East

Note:

I set a steel fence post with USFS Attention sign at corner, placed USFS 54-8 signs on all bearing trees and painted red band on smoothed bark at breast height on all bearing trees.

I hereby certify the above corner location was perpetuated as herein described October 27, 1981

Terry Butler Terry Butler, Witness

Frank Vaughn Frank Vaughn, Witness

REGISTERED  
PROFESSIONAL  
LAND SURVEYOR

Carl E. Sundet  
OREGON  
JULY 14, 1978  
CARL E. SUNDET  
1664

Office of..... County of.....  
State of....., I hereby certify that the within instrument was filed in this office  
for record on the..... day of....., 19.....  
..... by .....  
(COUNTY OFFICIAL) (DEPUTY)