



CERTIFIED RECORD OF LAND CORNER MONUMENTATION

History of original corner establishment:
None originally set.

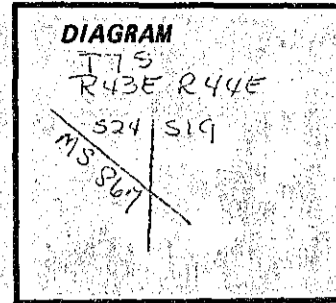

Description of corner evidence found:
None
None originally set.

Description of monument and accessories established to perpetuate the original location of this corner:
Set by intersection a 2 1/2" x 30" aluminum pipe with 3/4" aluminum cap 24" in ground in mound of stone, marked:

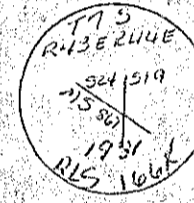

Bearing trees:
7" ponderosa pine - S56 1/2° E - 62.0 ft. - scribed "MS 867 S24"
in upper blaze and "BT" and brass tag stamped RLS 1664 in lower blaze.
8" ponderosa pine - N72 1/2° E - 18.7 ft. - scribed "MS 867 S19"
in upper blaze and "BT" and brass tag stamped RLS 1664 in lower blaze.
Compass declination 20° East

Note:
I set steel fence post with USFS Attention sign at corner, placed USFS 54-3 signs on all bearing trees and painted red band on smoothed bark at breast height on all bearing trees.

I hereby certify the above corner location was perpetuated as herein described in November 1981.

Terry Butler Terry Butler, Witness
Frank Vaughn Frank Vaughn, Witness

REGISTERED
PROFESSIONAL
LAND SURVEYOR

Carl E. Sundet

OREGON
JULY 14, 1978
CARL E. SUNDET
1664

Office of..... County of.....
State of..... I hereby certify that the within instrument was filed in this office
for record on the..... day of....., 19.....
..... by
(COUNTY OFFICIAL) (DEPUTY)

Form R6-7100-57 (9/71)

FILED Jan 5, 1982
BAKER COUNTY SURVEYOR
SURVEY NO. 7-43-50

☆ GPO-799-276