


CERTIFIED RECORD OF LAND CORNER MONUMENTATION

History of original corner establishment:

Corner established by W. Barr under contract #388 dated May 7, 1881.
Marked basalt rock 36" x 8" x 5" and raised a mound of stone.

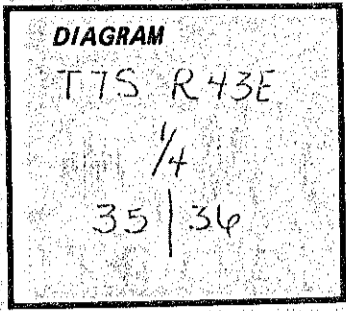

Description of corner evidence found:

Found:

36" x 8" x 5" stone with 1/4 on west face, in large mound of stone.

Description of monument and accessories established to perpetuate the original location of this corner:

Set 2 1/2" x 30" aluminum pipe with 3 1/4" aluminum cap 12" in ground in mound of stone, marked:
Buried original stone alongside pipe.



Bearing trees:

9" ponderosa pine - N22°W - 180.1 ft. - scribed "1/4 S35" in upper blaze and "BT" and brass tag stamped RLS 1664 in lower blaze.
14" ponderosa pine - N50 1/2°E - 145.5 ft. - scribed "1/4 S36" in upper blaze and "BT" and brass tag stamped RLS 1664 in lower blaze.

Compass declination 20° East

Note:

I set a steel fence post with USFS Attention sign at corner, placed USFS 54-3 signs on all bearing trees and painted red band on smoothed bark at breast height on all bearing trees.

I hereby certify the above corner location was perpetuated as herein described in November 1981.

Frank Vaughn Frank Vaughn, Witness
Terry Butler Terry Butler, Witness

REGISTERED
PROFESSIONAL
LAND SURVEYOR

Carl E. Sundet
OREGON
JULY 14, 1978
CARL E. SUNDET
1664

Office of..... County of.....
State of..... I hereby certify that the within instrument was filed in this office
for record on the..... day of....., 19.....
..... by

(COUNTY OFFICIAL)

(DEPUTY)

FILED Jan 5, 1982
BAKER COUNTY SURVEYOR
SURVEY NO. 7-43-51