


CERTIFIED RECORD OF LAND CORNER MONUMENTATION

History of original corner establishment:

Corner originally established by W. Barr, under contract no. 372, dated 1880.

Marked basalt rock 14" x 10" x 8". Raised mound of rock.

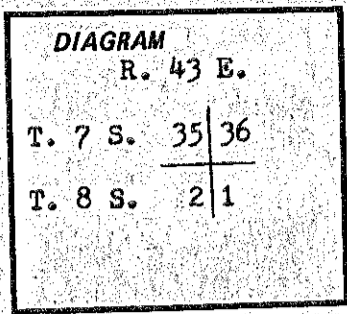

Description of corner evidence found:

Found weathered cinder stone in fence corner. No scribing visible.

Found 1 1/2" iron pipe at fence corner.

Found dead and down ponderosa pine, N 27° E, 4.92 chains as per 1919 retracement survey by Drake.

Description of monument and accessories established to perpetuate the original location of this corner: Set a 2 1/2" x 30" aluminum pipe with a 3/4" aluminum cap 15" in ground in mound of stone. Cap marked;

Reference Mounds

- 3ft. x 2 1/2ft. mound of stone, N 54° W, 7.4 ft.
- 3ft. x 3ft. mound of stone, N 56° E, 8.4 ft.
- 3ft. x 3ft. mound of stone, S 46° W, 8.9 ft.
- 3ft. x 3ft. mound of stone, S 36° E, 11.4 ft.

Compass declination 20° East


Note:

I set guard posts at corner with USFS 54-2 and 54-4 signs and place USFS 54-3 and 54-4 signs on reference mounds.

I hereby certify the above corner location was perpetuated as herein described on June 1, 1982.

Terry Butler Terry Butler, Witness

Frank Vaughn Frank Vaughn, Witness

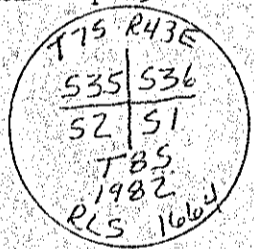

REGISTERED PROFESSIONAL LAND SURVEYOR

Carl E. Sunde

OREGON
JULY 14, 1978
CARL E. SUNDE
1664

Office of..... County of.....
 State of....., I hereby certify that the within instrument was filed in this office
 for record on the..... day of....., 19.....
 by..... (DEPUTY)
 (COUNTY OFFICIAL)