


CERTIFIED RECORD OF LAND CORNER MONUMENTATION

History of original corner establishment:

Corner originally established by W. Barr under contract #372, dated March 5, 1881.
Set basalt rock 28"x16"x8" in rock mound.

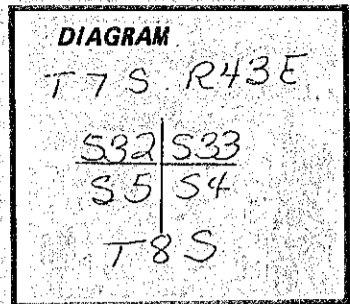

Description of corner evidence found:

Found 24"x16"x8" stone with 6 notches south in a mound of stone.

Description of monument and accessories I established to perpetuate the original location of this corner:

Set a 2½"x30" aluminum pipe with 3¼" aluminum cap 16" in ground in mound of stone, marked;
Buried original stone alongside pipe.



Accessories:

- 3'x2' stone mound - N53°W - 7.0 ft.
 - 4'x2' stone mound - N38°E - 9.6 ft.
 - 4'x2' stone mound - S41°W - 8.7 ft.
 - 4'x2' stone mound - S56°E - 9.9 ft.
- Compass declination 20° East

Note:

All mounds have USFS 54-3 and 54-4 signs in them.
I set a steel fence post with 54-4 sign 5' south of corner

I hereby certify the above corner location was perpetuated as herein described in September 1982.

Frank Vaughn Frank Vaughn, Witness

REGISTERED PROFESSIONAL LAND SURVEYOR

<u>Carl E. Sundet</u> OREGON JULY 14, 1978 CARL E. SUNDET 1664
--

Office of..... County of.....
 State of..... I hereby certify that the within instrument was filed in this office
 for record on the..... day of....., 19.....
 by
 (COUNTY OFFICIAL) (DEPUTY)