


CERTIFIED RECORD OF LAND CORNER MONUMENTATION

History of original corner establishment:

Corner originally established by W. Barr under contract #372, dated March 5, 1881. Set marked basalt rock, 16"x10"x5" and raised mound of rock.

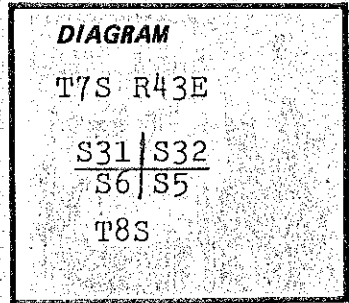


Description of corner evidence found:

Found 16"x10"x5" stone with 5 notches east and one notch west in a mound of stone.

Description of monument and accessories established to perpetuate the original location of this corner:

Set 2½" x 30" aluminum pipe with ¾" aluminum cap 20" in ground in mound of stone, marked; Buries original stone alongside pipe.

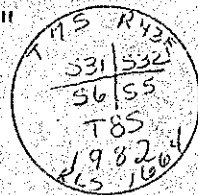

Accessories:

- 3'x2' mound of stone - N25°W - 12.6 ft.
- 3'x2' mound of stone - N71°E - 11.2 ft.
- 3'x2' mound of stone - S63°W - 10.3 ft.
- 3'x2' mound of stone - S21½°E - 7.6 ft.

Compass declination 20° East

Note:

I set a steel fence post with 54-4 sign 3' west of corner.

I hereby certify the above corner location was perpetuated as herein described in September 1982.

Frank Vaughn Frank Vaughn, Witness

REGISTERED PROFESSIONAL LAND SURVEYOR
---

Carl E. Sundet  
 OREGON  
 JULY 14, 1978  
 CARL E. SUNDET  
 1664

Office of..... County of.....  
 State of..... I hereby certify that the within instrument was filed in this office  
 for record on the..... day of....., 19.....  
 ..... by .....  
 (COUNTY OFFICIAL) (DEPUTY)