


CERTIFIED RECORD OF LAND CORNER MONUMENTATION

History of original corner establishment:

Corner originally established by W. Barr, under contract no. 372, dated 1880.

Marked basalt rock 24" x 10" x 10". Raised a mound of rock.

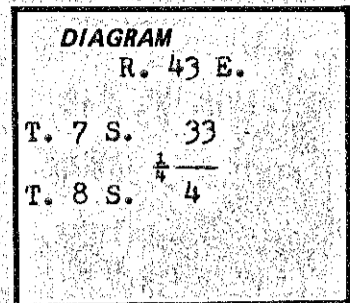

Description of corner evidence found:

Found 24" x 10" x 10" stone with 1/4 on north face, in a mound of stone.

Description of monument and accessories I established to perpetuate the original location of this corner:

Set 2 1/2" x 30" aluminum pipe with 3 1/4" aluminum cap 12" in ground to bedrock, in mound of stone, marked:
Buried original stone alongside.



Accessories:

- 4' x 2' mound of stone - S6°W - 7.0 ft.
- 5' x 2' mound of stone - East - 5.0 ft.

Compass declination 20.34° East

Note:

I set steel fence post at corner location with USFS attention sign, placed USFS bearing tree signs and attention signs on all accessories.

I hereby certify the above corner was perpetuated as herein described in November 1982

REGISTERED
PROFESSIONAL
LAND SURVEYOR

Carl E. Sundet

OREGON
JULY 14, 1978
CARL E. SUNDET
1664

Office of..... County of.....
 State of..... I hereby certify that the within instrument was filed in this office
 for record on the..... day of....., 19.....
 by

(COUNTY OFFICIAL)

(DEPUTY)

FILED Dec 20, 1982
 BAKER COUNTY SURVEYOR
 SURVEY NO. 2-43-61
8-43-32