


CERTIFIED RECORD OF LAND CORNER MONUMENTATION

History of original corner establishment:

Corner originally set by W. Barr under contract # 388, dated May 7, 1881

Surveyor General's records state: Marked basalt rock, 16"x9"x7" from which;

- a pine 15" in diameter bears S 36 W 55 links distance
- a fir 20" in diameter bears N 36 W 51 links distance
- a fir 15" in diameter bears S 64 E 80 links distance
- a pine 4" in diameter bears N 81 E 86 links distance

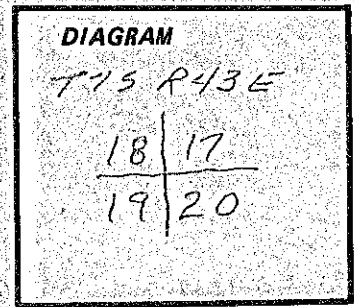

Description of corner evidence found:

Found:

- 22" ponderosa pine - N80°E - 86 lks - (live & healed face)
- 16" fir - S59°E - 80 lks - (dead and down)
- 20" ponderosa pine - S35°W - 61 lks - (dead and down)
- 20" fir - (dead and down) - rotten - 2 or 3 trees in area.

Cannot identify any as BP

No evidence of original stone.

Description of monument and accessories established to perpetuate the original location of this corner:

Set 3 1/4"x3" Aluminum rock cap 3" into rock, marked;

Bearing trees:

- 6" ponderosa pine - N72°W - 62.8 ft. - scribed "T75 R43E S18" in upper blaze and "BT" and brass tag stamped RLS 1664 in lower blaze
- 9" ponderosa pine - S77°W - 74.0 ft. - scribed "T75 R43E S19" in upper blaze and "BT" and brass tag stamped RLS 1664 in lower blaze.
- 9" ponderosa pine - S51°E - 65.1 ft. - scribed "T75 R43E S20" in upper blaze and "BT" and brass tag stamped RLS 1664 in lower blaze.


Compass declination 21 1/2° East

Note:

I set steel fence posts at corner with USFS Attention sign, placed USFS bearing tree signs on all bearing trees and painted red band on smooth bark at breast height on all bearing trees.

I hereby certify the above corner location was perpetuated as herein described in Nov 3 1982.

Terry Butler Terry Eutler, Witness
Frank Vaughn Frank Vaughn, Witness

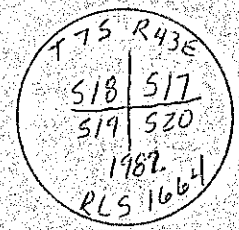

REGISTERED
 PROFESSIONAL
 LAND SURVEYOR

Carl E. Sundet

OREGON
 JULY 14, 1978
 CARL E. SUNDET
 1664

Office of..... County of.....
 State of..... I hereby certify that the within instrument was filed in this office
 for record on the..... day of....., 19.....
 by.....
 (COUNTY OFFICIAL) (DEPUTY)