


CERTIFIED RECORD OF LAND CORNER MONUMENTATION

History of original corner establishment:

None

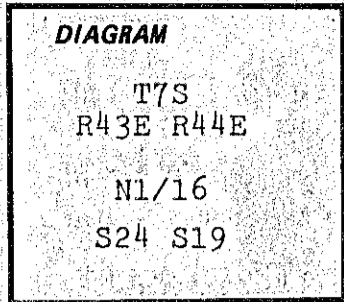


Description of corner evidence found:

None

Description of monument and accessories I established to perpetuate the original location of this corner:

Set 2½" x 30" aluminum pipe with ¾" aluminum cap 26" in ground in small mound of stone, marked:

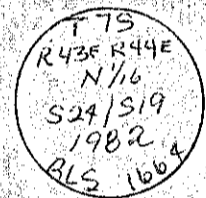

Bearing trees:

6" ponderosa pine - S66.5°E - 5.8 ft. scribed "N1/16 S19" in upper blaze and "BT" and brass tag stamped RLS 1664 in lower blaze  
 9" ponderosa pine - S55°W - 26.4 ft. scribed "N1/16 S24" in upper blaze and "BT" and brass tag stamped RLS 1664 in lower blaze

Compass declination 20° East

Note:

I set steel fence post at corner location with USFS 54-9 sign placed USFS bearing tree signs on all bearing trees and painted red band at breast height on smoothed bark on all bearing trees

I hereby certify the above corner was perpetuated as herein described in August 1982

REGISTERED  
PROFESSIONAL  
LAND SURVEYOR

Office of..... County of.....  
 State of....., I hereby certify that the within instrument was filed in this office  
 for record on the..... day of....., 19.....

*Carl E. Sundet*  
 OREGON  
 JULY 14, 1978  
 CARL E. SUNDET  
 1664

(COUNTY OFFICIAL)

(DEPUTY)

Form R6-7100-57 (9/71)

FILED DEC 20 1982

BAKER COUNTY SURVEYOR

SURVEY NO. 7-43-63

7-44-42