


CERTIFIED RECORD OF LAND CORNER MONUMENTATION

History of original corner establishment:

None

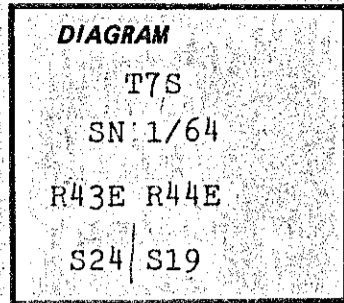


Description of corner evidence found:

None

Description of monument and accessories I established to perpetuate the original location of this corner:

Set 2 1/2" x 30" aluminum pipe with 3 1/4" aluminum cap 26" in ground in mound of stone, marked:

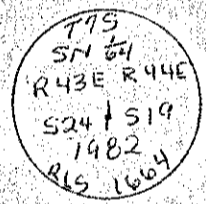

Bearing trees:

8" douglas fir - N20.5°E - 24.8 ft. scribed "SN1/64 S19" in upper blaze and "BT" and brass tag stamped RLS 1664 in lower blaze  
12" ponderosa pine - S87°W - 31.1 ft. scribed "SN1/64 S24" in upper blaze and "BT" and brass tag stamped RLS 1664 in lower blaze

Compass declination 20° East

Note:

I set steel fence post at corner location with USFS 54-9 sign, placed USFS bearing tree signs on all bearing trees and painted red band at breast height on smoothed bark on all bearing trees

I hereby certify the above corner was perpetuated as herein described in August 1982

REGISTERED PROFESSIONAL LAND SURVEYOR

Office of..... County of.....  
State of..... I hereby certify that the within instrument was filed in this office  
for record on the..... day of....., 19.....  
..... by .....

*Carl E. Sundet*  
OREGON  
JULY 14, 1978  
CARL E. SUNDET  
1664

(COUNTY OFFICIAL)

(DEPUTY)

FILED Dec 20 1982  
BAKER COUNTY SURVEYOR  
SURVEY NO. 7-43-64  
7-44-43