


CERTIFIED RECORD OF LAND CORNER MONUMENTATION

BUFFALO QUARTZ CLAIM

History of original corner establishment:

Henry W. Cooke, U. S. Deputy Mineral Surveyor was appointed by the U. S. Surveyor-General's office on April 1, 1887, to execute the mineral survey of this mining claim. No mineral survey number was established for this survey under this directive. Mr. Cooke assigned his own number (M. S. No.13) which is listed in the Bureau of Land Management records as M. S. No. 158A. For this reason the notes contain references to both those mineral survey numbers.

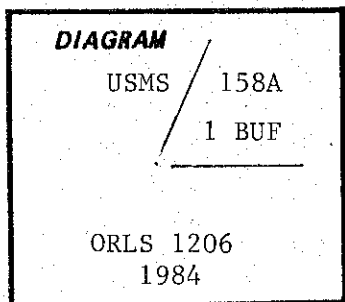

Hanley Engineering of Baker, Oregon, was engaged by William J. Wendt, owner of the Sanger Mine property, to survey and perpetuate the original Cooke patented claim corners by means of 2-inch diam. brass caps on 1-inch diam. galv. iron pipe posts. These monuments were set and not marked at that time. By Purchase Order No. 04M3-4-2010, the Wallowa-Whitman National Forest has authorized Hanley Engineering to maintain these monuments according to USFS R-6 Specifications for Cadastral Survey. They were die-stamped with the proper markings and referenced under this P.O.

Cooke set a post 4½ ft long 4 ins square 24 ins in ground marked Cor No 1 B.M.C. Sur No 13 from which

A fir 16 ins dia bears S 52° 20' E 18 ft dist marked Cor No 1 B.M.C. Sur No 13 B T

A fir 38 ins dia bears N.5° 50' E 28½ ft dist marked Cor No 1 B.M.C. Sur No 13 B T

Description of corner evidence found:

Monument described above, set in concrete, projecting 6 ins. above ground.

A 28-ins. diam. portion of down and decayed bearing tree, scribing visible and readable, bears N. 6° E., 30.6 ft.± dist.

Description of monument and accessories established to perpetuate the original location of this corner:

Stamped monument as shown on the diagram above. Constructed a surrounding stone mound.

New bearing trees:

8 1/2 ins. diam. western larch bears N. 67° W., 40.6 ft. dist., mkd. BUF 1 158A BT.

9 ins. diam. white fir bears S. 13° W., 51.9 ft. dist., mkd. BUF 1 158A.

I certify the monument was correctly marked and bearing trees established under my supervision on July 27, 1984, by Tom Fisk, Larry McBroom and Chris Mahoney.

Office of.....County..Surveyor..... County of..Baker.....
State of.....Oregon..... I hereby certify that the within instrument was filed in this office
for record on the..... day of....., 19.....

..... by
(COUNTY OFFICIAL) (DEPUTY)

Form R6-7100-57 (9/71)

FILED 2-12-1986
BAKER COUNTY SURVEYOR
SURVEY NO. 7-43-72

REGISTERED PROFESSIONAL LAND SURVEYOR
X GPO-788-278
James D. Hanley
OREGON
SEPTEMBER 23, 1977
JAMES D. HANLEY
1206