


Nellie Grant 1
Buffalo 2

CERTIFIED RECORD OF LAND CORNER MONUMENTATION

NELLIE GRANT QUARTZ CLAIM
BUFFALO QUARTZ CLAIM

History of original corner establishment:

Henry W. Cooke, U. S. Deputy Mineral Surveyor was appointed by the U. S. Surveyor-General's office on April 1, 1887, to execute the mineral survey of this mining claim. No mineral survey number was established for this survey under this directive. Mr. Cooke assigned his own number (M. S. No. 12) which is listed in the Bureau of Land Management records as M. S. No. 157A. For this reason the notes contain references to both those mineral survey numbers.

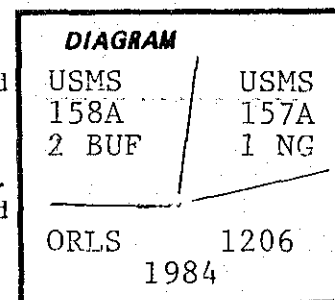

Hanley Engineering of Baker, Oregon, was engaged by William J. Wendt, owner of the Sanger Mine property, to survey and perpetuate the original Cooke patented claim corners by means of 2-inch diam. brass caps on 1-inch diam. galv. iron pipe posts. These monuments were set and not marked at that time. By Purchase Order No. 04M3-4-2010, the Wallowa-Whitman National Forest has authorized Hanley Engineering to maintain these monuments according to USFS R-6 Specifications for Cadastral Survey. They were die-stamped with the proper markings and referenced under this P.O.

Cooke set a post 4½ ft long 4 ins square in a mound of earth marked Cor No 1 N.G.M.C. Sur No 12 on NE face of post from which

A pine 20 ins dia bears N 17° 20' E 16 ft dist marked Cor No 1 N.G.M.C. Sur No 12 B T

Cooke marked Cor No 2 B.M.C. Sur No 13 on NW face of post (For Corner No. 2 of the Buffalo Claim, M S 158A) these claims sharing a common corner.

Description of corner evidence found:

Monument described above, set in concrete, projecting 6 ins. from the ground.

Stump of bearing tree established by Cooke, 24 ins. diam., all scribing legibile. Stump is 63 ins. high, bears N. 19° E., 17.0 ft. dist.

Description of monument and accessories established to perpetuate the original location of this corner:

Stamped monument as shown on the diagram above. Constructed surrounding stone mound.

New bearing trees:

12 ins. diam. white fir bears S. 50° W., 66.7 ft. dist., mkd BUF 2 158A
NG 1 157A BT.

12 ins. diam. P. pine bears S. 58° E., 53.2 ft., dist., mkd. BUF 2 158A
NG 1 157A BT.

I certify the monument was correctly marked and bearing trees established under my supervision on July 27, 1984, witnessed by Tom Fisk, Larry McBroom and Chris Mahoney.

Office of... County Surveyor..... County of Baker.....