


CERTIFIED RECORD OF LAND CORNER MONUMENTATION

BUFFALO QUARTZ CLAIM

History of original corner establishment:

Henry W. Cooke, U. S. Deputy Mineral Surveyor was appointed by the U. S. Surveyor-General's office on April 1, 1887, to execute the mineral survey of this mining claim. No mineral survey number was established for this survey under this directive. Mr. Cooke assigned his own number (M. S. No. 13) which is listed in the Bureau of Land Management records as M. S. No. 158A. For this reason the notes contain references to both those mineral survey numbers.

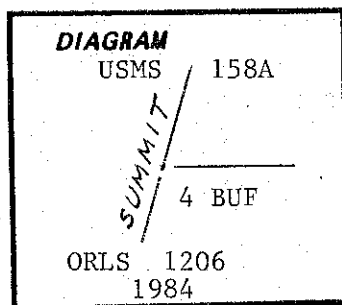

Hanley Engineering of Baker, Oregon, was engaged by William J. Wendt, owner of the Sanger Mine property, to survey and perpetuate the original Cooke patented claim corners by means of 2-inch diam. brass caps on 1-inch diam. galv. iron pipe posts. These monuments were set and not marked at that time. By Purchase Order No. 04M3-4-2010, the Wallowa-Whitman National Forest has authorized Hanley Engineering to maintain these monuments according to USFS R-6 Specifications for Cadastral Survey. They were die-stamped with the proper markings and referenced under this P.O.

Cooke set a post 4½ feet long 4 ins square 24 ins in the ground marked Cor No 4 B.M.C. Sur No 13 on SE face of post from which

A fir 20 ins dia bears N 88° 30' W 34½ feet dist marked Cor No 4 B.M.C. Sur No 13 F T

A fir 36 ins dia bears S 89° 30' E 92 feet dist marked Cor No 4 B.M.C. Sur No 13 B T

Description of corner evidence found:

Monument described above, set in concrete, projecting 6 ins. above ground.

Fir bearing tree, now 39 ins. diam., bears S. 87° E., 82.1 ft. dist., scribing partly legible.

Description of monument and accessories established to perpetuate the original location of this corner:

Stamped monument as shown on above diagram. Constructed surrounding stone mound. New bearing trees:

7½ ins. diam. pine, bears N. 72½° W., 37.7 ft. dist., mkd. BUF 4 158A BT.

8 ins. diam. white fir bears N. 51° E., 37.7 ft. dist., mkd BUF 4 158A BT.

I certify the monument was correctly marked and bearing trees established under my supervision on July 27, 1984, by Tom Fisk, Larry McBroom and Chris Mahoney.

Office of...County Surveyor..... County of.....Baker.....  
State of.....Oregon....., I hereby certify that the within instrument was filed in this office  
for record on the..... day of....., 19.....  
..... by .....  
(COUNTY OFFICIAL) (DEPUTY)

Form R6-7100-57 (9/71)

FILED 2-12-1986  
BAKER COUNTY SURVEYOR  
SURVEY NO. 7-43-75

REGISTERED PROFESSIONAL LAND SURVEYOR  
*James D. Hanley*  
OREGON  
SEPTEMBER 23, 1977  
JAMES D. HANLEY  
1206