


CERTIFIED RECORD OF LAND CORNER MONUMENTATION

BUFFALO MILL SITE

History of original corner establishment:

Henry W. Cooke, U. S. Deputy Mineral Surveyor was appointed by the U. S. Surveyor-General's office on April 1, 1887, to execute the mineral survey of this mining claim. No mineral survey number was established for this survey under this directive. Mr. Cooke assigned his own number (M. S. No. 13) which is listed in the Bureau of Land Management records as M. S. No. 158B. For this reason the notes contain references to both those mineral survey numbers.

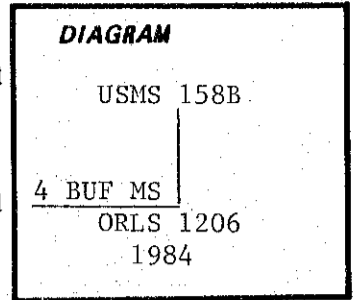

Hanley Engineering of Baker, Oregon, was engaged by William J. Wendt, owner of the Sanger Mine property, to survey and perpetuate the original Cooke patented claim corners by means of 2-inch diam. brass caps on 1-inch diam. galv. iron pipe posts. These monuments were set and not marked at that time. By Purchase Order No. 04M3-4-2010, the Wallowa-Whitman National Forest has authorized Hanley Engineering to maintain these monuments according to USFS R-6 Specifications for Cadastral Survey. They were die-stamped with the proper markings and referenced under this P.O.

Cooke set a post 4½ ft long 4 ins square in stone mound marked Cor No 4 Sur No 13

Description of corner evidence found:

Monument described above, set in concrete, projecting about 6 ins. above the ground.

Description of monument and accessories | established to perpetuate the original location of this corner:

Stamped the existing monument as shown on the diagram above, constructed a surrounding stone mound.

New bearing trees:

- 13 ins. diam. pine bears S. 40° E., 12.0 ft. dist., mkd. BUF MS 4 158B BT.
- 11 ins. diam D. fir bears N. 52½° E., 21.4 ft. dist., mkd. BUF MS 4 158B BT.

I certify the monument was correctly marked and bearing trees established under my supervision, July, 1984, witnessed by Tom Fisk, Larry McBroom and Chris Mahoney.

Office of..... County Surveyor..... County of..... Baker  
 Oregon  
 State of....., I hereby certify that the within instrument was filed in this office  
 for record on the..... day of....., 19.....  
 ..... by .....  
 (COUNTY OFFICIAL) (DEPUTY)

Form R6-7100-57 (9/71)

FILED 2-12-1986  
 BAKER COUNTY SURVEYOR  
 SURVEY NO. 7-43-77

REGISTERED  
 PROFESSIONAL  
 LAND SURVEYOR

*James D. Hanley*

OREGON  
 SEPTEMBER 23, 1977  
 JAMES D. HANLEY  
 1206