


CERTIFIED RECORD OF LAND CORNER MONUMENTATION

C. T. BRADLEY MILL SITE

History of original corner establishment:

Henry W. Cooke, U. S. Deputy Mineral Surveyor was appointed by the U. S. Surveyor-General's office on April 1, 1887, to execute the mineral survey of this mining claim. No mineral survey number was established for this survey under this directive. Mr. Cooke assigned his own number (M. S. No. 12) which is listed in the Bureau of Land Management records as M. S. No. 157B. For this reason the notes contain references to both those mineral survey numbers.

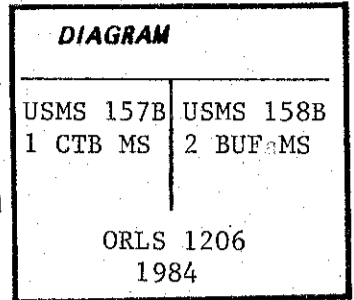

Hanley Engineering of Baker, Oregon, was engaged by William J. Wendt, owner of the Sanger Mine property, to survey and perpetuate the original Cooke patented claim corners by means of 2-inch diam. brass caps on 1-inch diam. galv. iron pipe posts. These monuments were set and not marked at that time. By Purchase Order No. 04M3-4-2010, the Wallowa-Whitman National Forest has authorized Hanley Engineering to maintain these monuments according to USFS R-6 Specifications for Cadastral Survey. They were die-stamped with the proper markings and referenced under this P.O.

Cooke set a post 4 ft long 4 ins square in a mound of stone marked Cor No 1 B.M.S. Sur No 12. He also marked Cor No 2 B.M.S. Sur No 13 (for Buffalo Mill Site) on the SE face of post, the corner being common to both mill sites.

Description of corner evidence found:

None. This corner was not reestablished during the William J. Wendt survey.

Description of monument and accessories established to perpetuate the original location of this corner:

Set a 2-inch diam. brass cap on a 1-inch diam. galv. iron pipe post, 30 ins. long, 27 ins. in the ground surrounded by a stone mound, marked as shown on the diagram above.

New bearing trees:

11 ins. diam. white fir bears N. 28° E., 52.7 ft. dist., mkd. BUF MS 2 158B CTB MS 1 157 B BT.

13 ins. diam. P pine bears N. 77° E., 42.5 ft. dist., mkd. BUF MS 2 158B CTB MS 157B BT.

I certify the monument was correctly set and marked and bearing trees were established under my supervision, July, 1984, witnessed by Tom Fisk, Larry McBroom

Office of.....County Surveyor..... County of...Baker..... and Chris Mahoney.

State of.....Oregon.... I hereby certify that the within instrument was filed in this office

for record on the..... day of....., 19.....

..... by

(COUNTY OFFICIAL)

(DEPUTY)

Form R6-7100-57 (9/71)

FILED 2-12-1986
BAKER COUNTY SURVEYOR
SURVEY NO. 7-43-78

