


CERTIFIED RECORD OF LAND CORNER MONUMENTATION

C. T. BRADLEY MILL SITE

History of original corner establishment:

Henry W. Cooke, U. S. Deputy Mineral Surveyor was appointed by the U. S. Surveyor-General's office on April 1, 1887, to execute the mineral survey of this mining claim. No mineral survey number was established for this survey under this directive. Mr. Cooke assigned his own number (M. S. No. 12) which is listed in the Bureau of Land Management records as M. S. No. 157B. For this reason the notes contain references to both those mineral survey numbers.

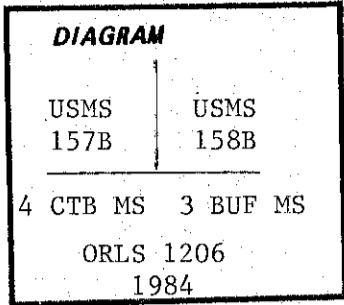

Hanley Engineering of Baker, Oregon, was engaged by William J. Wendt, owner of the Sanger Mine property, to survey and perpetuate the original Cooke patented claim corners by means of 2-inch diam. brass caps on 1-inch diam. galv. iron pipe posts. These monuments were set and not marked at that time. By Purchase Order No. 04M3-4-2010, the Wallowa-Whitman National Forest has authorized Hanley Engineering to maintain these monuments according to USFS R-6 Specifications for Cadastral Survey. They were die-stamped with the proper markings and referenced under this P.O.

Cooke set a post 4 ft long 4 ins in square in mound of stone marked Cor No 4 B.M.S. Sur No. 12. He also marked Cor No 3 B.M.S. Sur No 13 (for Buffalo Mill Site M. S. No. 158B) on NE face of post, the corner being common to both mill sites.

Description of corner evidence found:

None

Description of monument and accessories established to perpetuate the original location of this corner:

Set an iron pipe 30 ins. long, 1-inch diam., 24 ins. in the ground, with a surrounding stone mound. 2-inch brass cap is marked as shown on the above diagram.

New bearing trees:

16 ins. diam. Douglas fir bears S. 62½° W., 40.7 ft. dist., marked CTB MS 4 157B BUF MS 3 158B BT.

12 ins. diam. Ponderosa pine bears S. 7½° E., 51.1 ft. dist., mkd. CTB MS 4 157 B BUF MS 3 158B BT.

I certify the monument as shown on the diagram above was correctly set and marked as shown July, 1984, witnessed by Tom Fisk, Larry McBroom, Chris Mahoney.

Office of..... County Surveyor..... County of... Baker
State of..... Oregon....., I hereby certify that the within instrument was filed in this office for record on the..... day of....., 19.....
..... by
(COUNTY OFFICIAL) (DEPUTY)

Form R6-7100-57 (9/71)

FILED 2-12-1986
BAKER COUNTY SURVEYOR
SURVEY NO. 7-43-81

REGISTERED
PROFESSIONAL
LAND SURVEYOR

James D. Hanley

OREGON
SEPTEMBER 23, 1977
JAMES D. HANLEY
1206