


CERTIFIED RECORD OF LAND CORNER MONUMENTATION

GOLDEN EAGLE QUARTZ CLAIM

History of original corner establishment:

Henry W. Cooke, U. S. Deputy Mineral Surveyor was appointed by the U. S. Surveyor-General's office on April 1, 1887, to execute the mineral survey of this mining claim. No mineral survey number was established for this survey under this directive. Mr. Cooke assigned his own number (M. S. No. 7) which is listed in the Bureau of Land Management records as M. S. No. 146. For this reason the notes contain references to both those mineral survey numbers.

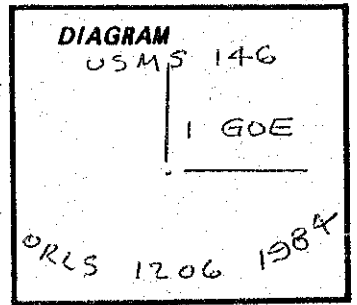

Hanley Engineering of Baker, Oregon, was engaged by William J. Wendt, owner of the Sanger Mine property, to survey and perpetuate the original Cooke patented claim corners by means of 2-inch diam. brass caps on 1-inch diam. galv. iron pipe posts. These monuments were set and not marked at that time. By Purchase Order No. 04M3-4-2010, the Wallowa-Whitman National Forest has authorized Hanley Engineering to maintain these monuments according to USFS R-6 Specifications for Cadastral Survey. They were die-stamped with the proper markings and referenced under this P.O.

Cooke set a post 4½ ft long 4 ins square in a mound of stone marked Cor No 1 G.E.M.C. Sur No 7 on NE face of post from which

A pine 12 ins dia bears S 12° E 32 ft dist marked Cor No 1 G.E.M.C. Sur No 7 B T

A pine 10 ins dia bears N 23° E 35 ft dist marked Cor No 1 G.E.M.C. Sur No 7 B T

Description of corner evidence found:

Monument described above, set in concrete, projecting 6 ins. from the ground.

21 ins. diam. pine B T, S. 10½° E., 37.6 ft. dist. with scar facing cor. monument.

14 ins. diam. B T stump, N. 23° E., 36.6 ft. dist. with scar facing cor. monument.

Description of monument and accessories established to perpetuate the original location of this corner:

Stamped monument as shown on diagram above. Constructed a surrounding stone mound.

New Douglas fir B T, 11 ins. diam., bears N. 22° W., 24.2 ft. dist., mkd. GOE--1-146 BT

I certify the monument was correctly marked and bearing tree established under my supervision on July 23, 1984, witnessed by Tom Fisk, Larry McBroom and Chris Mahoney.

Office of.....County..Surveyor..... County of....Baker,.....
State of.....Oregon....., I hereby certify that the within instrument was filed in this office
for record on the..... day of....., 19.....

..... by
(COUNTY OFFICIAL) (DEPUTY)

Form R6-7100-57 (9/71)

FILED 2-12-1986
BAKER COUNTY SURVEYOR
SURVEY NO. 7-43-82

