


CERTIFIED RECORD OF LAND CORNER MONUMENTATION

KNIGHT QUARTZ CLAIM

History of original corner establishment:

Henry W. Cooke, U. S. Deputy Mineral Surveyor was appointed by the U. S. Surveyor-General's office on April 1, 1887, to execute the mineral survey of this mining claim. No mineral survey number was established for this survey under this directive. Mr. Cooke assigned his own number (M. S. No. 9) which is listed in the Bureau of Land Management records as M. S. No. 145. For this reason the notes contain references to both those mineral survey numbers.

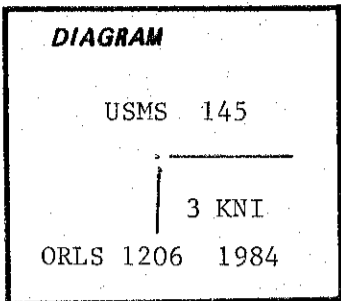

Hanley Engineering of Baker, Oregon, was engaged by William J. Wendt, owner of the Sanger Mine property, to survey and perpetuate the original Cooke patented claim corners by means of 2-inch diam. brass caps on 1-inch diam. galv. iron pipe posts. These monuments were set and not marked at that time. By Purchase Order No. 04M3-4-2010, the Wallowa-Whitman National Forest has authorized Hanley Engineering to maintain these monuments according to USFS R-6 Specifications for Cadastral Survey. They were die-stamped with the proper markings and referenced under this P.O.

Cooke set a post 4½ ft long 4 ins square in a mound of stone marked Cor No 3 K.M.C. Sur No 9 on SE face of post from which

A pine 20 ins dia bears S 60° E 12 ft dist marked Cor No 3 K.M.C. Sur No 9 B T

A pine 36 ins dia bears N 18° 30' W 14 ft dist marked Cor No 3 K.M.C. Sur No 9 B T

Description of corner evidence found:

Monument described above, set in concrete, projects about 6 ins. above the ground.

Stump hole N. 18° 30' W., 16'± dist.

Remains of burned stump, no scribing remaining, at record bearing and distance for 20 ins. diam. pine .

Description of monument and accessories established to perpetuate the original location of this corner:

Marked the monument, with proper corner data, but for the NE quadrant. Should be the SE quadrant. Marked as follows:

USMS 145

Constructed a stone mound around monument.

3 KNI

ORLS 1206 1984

New bearing trees:

15 ins. diam. P. pine bears N. 25° W., 9.3 ft. dist., mkd. KNI 3 145 BT.

11 ins. diam. P. pine bears S. 87° E., 21.4 ft. dist., mkd. KNI 3 145 BT.

Office of County Surveyor..... County of Baker.....  
State of Oregon....., I hereby certify that the within instrument was filed in this office  
for record on the..... day of....., 19.....

..... by .....

(COUNTY OFFICIAL)

(DEPUTY)

Form R6-7100-57 (9/71)

I certify the monument was marked as described and bearing trees correctly established July 30, 1984, under my supervision, witnessed by Tom Fisk, Larry McBroom and Chris Mahoney.

FILED 2-12-1986

BAKER COUNTY SURVEYOR

SURVEY NO. 7-43-86

