


CERTIFIED RECORD OF LAND CORNER MONUMENTATION

History of original corner establishment:

Henry W. Cooke, U. S. Deputy Mineral Surveyor was appointed by the U. S. Surveyor-General's office on April 1, 1887, to execute the mineral survey of this mining claim. No mineral survey number was established for this survey under this directive. Mr. Cooke assigned his own number (M. S. No.) which is listed in the Bureau of Land Management records as M. S. No. For this reason the notes contain references to both those mineral survey numbers.

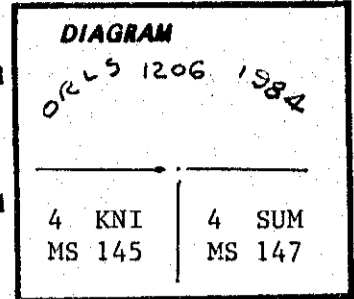

Hanley Engineering of Baker, Oregon, was engaged by William J. Wendt, owner of the Sanger Mine property, to survey and perpetuate the original Cooke patented claim corners by means of 2-inch diam. brass caps on 1-inch diam. galv. iron pipe posts. These monuments were set and not marked at that time. By Purchase Order No. 04M3-4-2010, the Wallowa-Whitman National Forest has authorized Hanley Engineering to maintain these monuments according to USFS R-6 Specifications for Cadastral Survey. They were die-stamped with the proper markings and referenced under this P.O.

Cooke set a post 4½ fe. long 4 ins square in mound of stone marked Cor No 4 S.M.C.Sur No 8 from which

A pine 36 ins dia bears S 23° 45' E 41 ft dist marked Cor No 4 S.M.C. Sur No 8 BT

A fir 20 ins dia bears N 55° 30' W 25 ft dist marked Cor No 4 S.M.C. Sur No 8 BT

This is also Corner No. 4 of the Knight Claim. Cooke marked Cor N 4 K.M.C. Sur No 9 on the SW face of this post.

Description of corner evidence found:

Monument described above, set in concrete, projecting 6 ins. above the ground.

Pine bearing tree stump, now 41 ins. diam. bears S. 19° E., 43.2 ft. dist., mkd. COR 4 SU on partially healed blaze.

Fir bearing tree, 29 ins. diam. bears N. 54° W., 26.6 ft. dist., markings in blaze healed over.

Description of monument and accessories I established to perpetuate the original location of this corner:

Stamped the monument as shown on diagram above. Constructed surrounding stone mound.

New bearing tree:

10 ins. diam. tamarack, bears N. 27½° E., 13.6 ft. dist., mkd. KNI 4 145 BT.

I certify the monument as shown on the diagram above was correctly marked as described on July 30, 1984, witnessed by Tom Fisk and Chris Mahoney.

Office of...County Surveyor..... County of...Baker.....
 State of...Oregon..... I hereby certify that the within instrument was filed in this office
 for record on the..... day of....., 19.....
 by
 (COUNTY OFFICIAL) (DEPUTY)

Form R6-7100-57 (9/71)

FILED 2-12-1986
BAKER COUNTY SURVEYOR
SURVEY NO. 7-43-87

