


CERTIFIED RECORD OF LAND CORNER MONUMENTATION

NELLIE GRANT QUARTZ CLAIM

History of original corner establishment:

Henry W. Cooke, U. S. Deputy Mineral Surveyor was appointed by the U. S. Surveyor-General's office on April 1, 1887, to execute the mineral survey of this mining claim. No mineral survey number was established for this survey under this directive. Mr. Cooke assigned his own number (M. S. No. 12) which is listed in the Bureau of Land Management records as M. S. No. 157A. For this reason the notes contain references to both those mineral survey numbers.

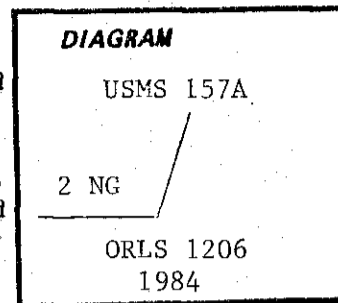

Hanley Engineering of Baker, Oregon, was engaged by William J. Wendt, owner of the Sanger Mine property, to survey and perpetuate the original Cooke patented claim corners by means of 2-inch diam. brass caps on 1-inch diam. galv. iron pipe posts. These monuments were set and not marked at that time. By Purchase Order No. 04M3-4-2010, the Wal-lowa-Whitman National Forest has authorized Hanley Engineering to maintain these monuments according to USFS R-6 Specifications for Cadastral Survey. They were die-stamped with the proper markings and referenced under this P.O.

Cooke set a post 4½ ft long 4 ins square (in the hollow of a pine tree 30 ins in dia) marked Cor No 2 N.G.M.C. Sur No 12 from which

A pine 38 ins dia bears N 60° E 67 ft dist marked Cor No 2 N.G M.C. Sur No 12 B T

Description of corner evidence found:

Monument described above, set in concrete, projecting about 6 ins. above the ground.

A pine stump, 24 ins. high, 36 ins. diam., bears N. 62° E., 68.9 ft. dist. with no visible markings.

Description of monument and accessories established to perpetuate the original location of this corner:

Stamped monument as shown on diagram above, Constructed a surrounding stone mound.

New bearing trees:

12 ins. diam. D. fir bears N. 54° E., 52.0 ft. dist., mkd. NG 2 157A BT.

12 ins. diam. pine bears S. 03° E., 71.1 ft. dist., mkd NG 2 157A BT.

I certify the monument was correctly marked and the bearing trees established under my supervision on July, 1984, witnessed by Tom Fisk, Larry McBroom and Chris Mahoney.

Office of..... County Surveyor..... County of..... Baker
Oregon
State of....., I hereby certify that the within instrument was filed in this office
for record on the..... day of....., 19.....

(COUNTY OFFICIAL)

(DEPUTY)

Form R6-7100-57 (9/71)

FILED 2-12-1986

BAKER COUNTY SURVEYOR

SURVEY NO. 7-43-88

REGISTERED
PROFESSIONAL
LAND SURVEYORJames D. Hanley
OREGON
SEPTEMBER 23, 1977
JAMES D. HANLEY
1206