


CERTIFIED RECORD OF LAND CORNER MONUMENTATION

NELLIE GRANT QUARTZ CLAIM

History of original corner establishment:

Henry W. Cooke, U. S. Deputy Mineral Surveyor was appointed by the U. S. Surveyor-General's office on April 1, 1887, to execute the mineral survey of this mining claim. No mineral survey number was established for this survey under this directive. Mr. Cooke assigned his own number (M. S. No. 12) which is listed in the Bureau of Land Management records as M. S. No. 157A. For this reason the notes contain references to both those mineral survey numbers.

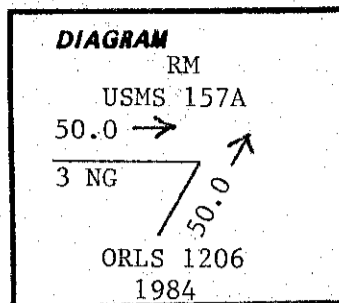

Hanley Engineering of Baker, Oregon, was engaged by William J. Wendt, owner of the Sanger Mine property, to survey and perpetuate the original Cooke patented claim corners by means of 2-inch diam. brass caps on 1-inch diam. galv. iron pipe posts. These monuments were set and not marked at that time. By Purchase Order No. 04M3-4-2010, the Wallowa-Whitman National Forest has authorized Hanley Engineering to maintain these monuments according to USFS R-6 Specifications for Cadastral Survey. They were die-stamped with the proper markings and referenced under this P.O.

Cooke set a post 4½ ft long 5 ins square 24 ins in ground marked Cor No 3 N.G.M.C. Sur No 12 on SW face of post from which

A fir 16 ins dia bears N 13° 30' W 21 ft dist marked Cor No 3 N.G.M.C. Sur No. 12 B T

A fir 20 ins dia bears S 41° 35' W 17½ ft dist marked Cor No 3 N.G.M.C. Sur No 12 B T

Description of corner evidence found:

Remains of old stump, precise original location not determined, now bears S. 41° W., 20 ft. dist. mkd. COR NO 3 NG MC SUR NO . . BT. Size not determinable.

Two brass-capped monuments, set in concrete, projecting about 6 ins. above ground. One bears S. 73° 37' 10" W., 50.0 ft. dist., the other bears S. 08° 10' 20" W., 50.0 ft. dist.

Description of monument and accessories | established to perpetuate the original location of this corner:

Stamped the existing monuments as shown on the above diagram. One has arrow pointing N. 73° 37' 10" E., and the other points N. 08° 10' 20" E. Drawing of the two are combined on diagram above. Constructed a surrounding stone mound around each monument.

I certify the monuments as shown on the diagram above were correctly marked as shown July, 1984, witnessed by Tom Fisk, Larry McBroom and Chris Mahoney.

Office of..... County Surveyor..... County of..... Baker.....
 State of..... Oregon....., I hereby certify that the within instrument was filed in this office
 for record on the..... day of....., 19.....
 by
 (COUNTY OFFICIAL) (DEPUTY)

Form R6-7100-57 (9/71)

FILED 2-12-1986
 BAKER COUNTY SURVEYOR
 SURVEY NO. 7-43-89

REGISTERED
 PROFESSIONAL
 LAND SURVEYOR
James D. Hanley
 OREGON
 SEPTEMBER 23, 1977
 JAMES D. HANLEY
 1206