


CERTIFIED RECORD OF LAND CORNER MONUMENTATION

SUMMIT QUARTZ CLAIM

History of original corner establishment:

Henry W. Cooke, U. S. Deputy Mineral Surveyor was appointed by the U. S. Surveyor-General's office on April 1, 1887, to execute the mineral survey of this mining claim. No mineral survey number was established for this survey under this directive. Mr. Cooke assigned his own number (M. S. No. 8) which is listed in the Bureau of Land Management records as M. S. No. 147. For this reason the notes contain references to both those mineral survey numbers.

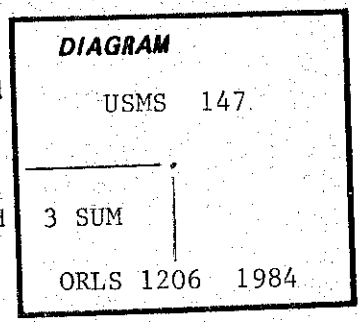

Hanley Engineering of Baker, Oregon, was engaged by William J. Wendt, owner of the Sanger Mine property, to survey and perpetuate the original Cooke patented claim corners by means of 2-inch diam. brass caps on 1-inch diam. galv. iron pipe posts. These monuments were set and not marked at that time. By Purchase Order No. 04M3-4-2010, the Wal-lowa-Whitman National Forest has authorized Hanley Engineering to maintain these monuments according to USFS R-6 Specifications for Cadastral Survey. They were die-stamped with the proper markings and referenced under this P.O.

Cooke set a post 4½ ft long 4 ins square 12 ins in ground marked Cor No 3 S.M.C. Sur No 8 from which

A fir 20 ins dia bears S 59° W 10½ ft dist marked Cor No 3 S.M.C. Sur No 8 B T

A fir 20 ins dia bears S 46½° E 18½ ft dist marked Cor No 3 S.M.C. Sur No 8 B T

Description of corner evidence found:

Monument described above, set in concrete, projects about 6 ins. above the ground. Root holes at record bearing and distance, only evidence of original bearing trees.

Description of monument and accessories established to perpetuate the original location of this corner:

Stamped monument as shown on diagram above and constructed a surrounding stone mound.

New bearing trees:

- 9 ins. diam. Douglas fir bears N. 81° E., 10.8 ft. dist., mkd. SUM 3 147 BT.
- 7 ins. diam. white fir bears S. 25° E., 10.3 ft. dist., mkd. SUM 3 147 BT.

I certify the monument was correctly marked and bearing trees established under my supervision on July 27, 1984, witnessed by Tom Fisk, Larry McBroom and Chris Mahoney.

Office of.....County..Surveyor..... County of.....Baker.....
 State of.....Oregon....., I hereby certify that the within instrument was filed in this office
 for record on the..... day of....., 19.....
 by (DEPUTY)
 (COUNTY OFFICIAL)

Form R6-7100-57 (9/71)

FILED 2-12-1986
 BAKER COUNTY SURVEYOR
 SURVEY NO. 7-43-93

REGISTERED
 PROFESSIONAL
 LAND SURVEYOR

James D. Hanley

OREGON
 SEPTEMBER 23, 1977
 JAMES D. HANLEY
 1206