


CERTIFIED RECORD OF LAND CORNER MONUMENTATION

History of original corner establishment:

Corner not previously established.

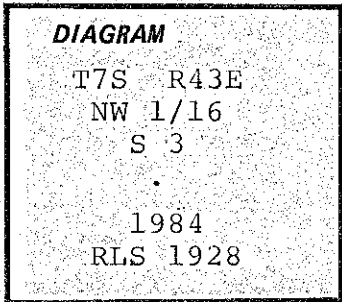

Description of corner evidence found:

Corner not previously established.

Description of monument and accessories I established to perpetuate the original location of this corner:

Set 30" aluminum pipe with 3/4" aluminum cap 8" above ground and marked as shown above.

Steel post next to cap with signs 54-9 and 54-2.


Scribed:

- 5" Fir "NW 1/16 S3 BT" S89E 29.8 ft.
- 8" Fir "NW 1/16 S3 BT" N20E 24.9 ft.

Nailed aluminum washers stamped "RLS 1928" above "BT" on both trees.

Nailed bearing tree signs above blaze and land survey monument signs on back of each tree.

Painted blazes red and a 6" red band above blaze on both trees.

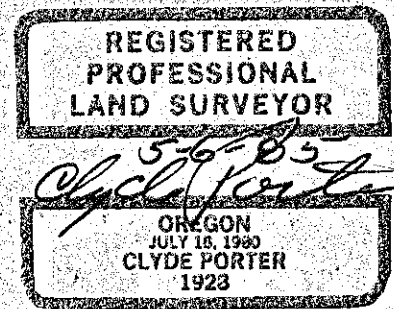

Office of..... County of.....

State of....., I hereby certify that the within instrument was filed in this office for record on the..... day of....., 19.....

..... by

(COUNTY OFFICIAL)

(DEPUTY)

FILED 5-9-80

BAKER COUNTY SURVEYOR

SURVEY NO. 7-43-100