

CERTIFIED RECORD OF LAND CORNER MONUMENTATION


History of original corner establishment:

Original corner established in 1881 by W. B. Barr under Contract #388.

Set basalt rock 12" x 10" x 5"

Scribed:

15" Fir S12E 20 lks  
18" Tamarack S40W 58 lks

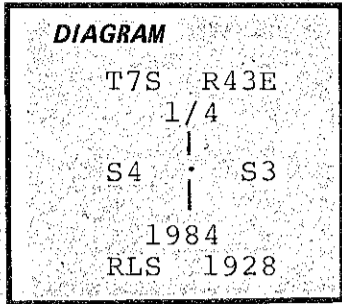

Description of corner evidence found:

None

Description of monument and accessories established to perpetuate the original location of this corner:

Set 30" Aluminum pipe with 3 1/4" aluminum cap 6" above ground marked as shown above.

Steel post 4' west with signs 54-9 and 54-2.


Scribed:

6" Fir "1/4 S3 BT" N42E 43.6 ft.  
6" Fir "1/4 S4 BT" S67W 53.0 ft.

Nailed aluminum washers stamped "PLS 1928" above "BT" scribe on both trees.

Nailed bearing tree signs above blaze and land survey monument signs on back of each tree.

Painted blazes red and a 6" red band above blaze on both trees.

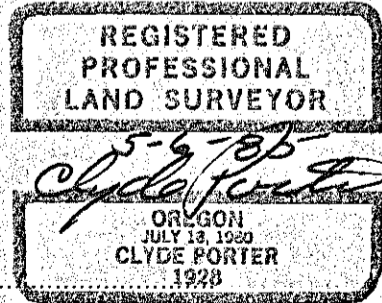

Office of..... County of.....  
 State of....., I hereby certify that the within instrument was filed in this office  
 for record on the..... day of....., 19.....  
 by.....  
 (COUNTY OFFICIAL) (DEPUTY)

FILED 5-9-86  
 BAKER COUNTY SURVEYOR  
 SURVEY NO. 7-43-102