


CERTIFIED RECORD OF LAND CORNER MONUMENTATION

History of original corner establishment:

Corner not previously established.

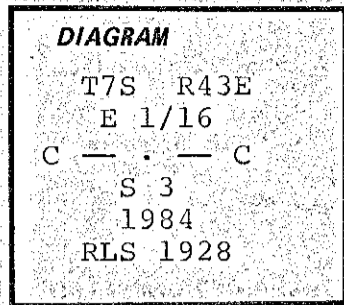

Description of corner evidence found:

Corner not previously established.

Description of monument and accessories I established to perpetuate the original location of this corner:

Set 30" aluminum pipe with a 3/4" aluminum cap 18" above ground and mounded with rocks, marked as shown above.

Steel post 3' east with signs 54-9 and 54-2.


Scribed:

- 7" Fir "C-E 1/16 S3 BT" N50E 34.6 ft.
- 7" Pine "C-E 1/16 S3 BT" N88W 24.3 ft.

Nailed aluminum washers stamped "RLS 1928" above "BT" scribe on both trees.

Nailed bearing tree signs above blazes and land survey monument signs on back of each tree.

Painted blazes red and a 6" red band above blaze on each tree.

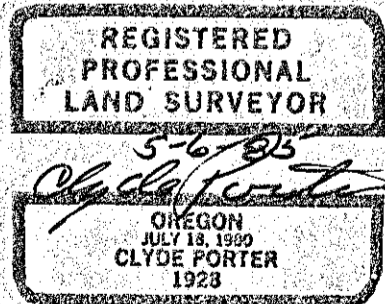

Office of..... County of.....
 State of....., I hereby certify that the within instrument was filed in this office
 for record on the..... day of....., 19.....
 by
 (COUNTY OFFICIAL) (DEPUTY)

FILED 5-9-86
 BAKER COUNTY SURVEYOR
 SURVEY NO. 7-43-105