


CERTIFIED RECORD OF LAND CORNER MONUMENTATION

History of original corner establishment:

Original corner established in 1881 by
W. B. Barr under Contract #388.

Set quartz rock 12" x 10" x 6".

Scribed:
20" Pine West 16 lks
12" Pine S60E 39 lks

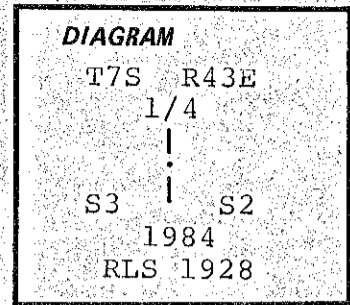

Description of corner evidence found:

NONE

Description of monument and accessories I established to perpetuate the original location of this corner:

Set 30" aluminum pipe with 3/4" aluminum cap 12" above ground with rock pile to base of cap, marked as shown above.


Steel post 3' east with sign 54-9.

Scribed:
9" Pine "1/4 S2 BT" N54E 68.8 ft.
9" Pine "1/4 S3 BT" S44W 12.6 ft.

Nailed aluminum washers stamped "RLS 1928" above "BT" scribe on both trees.

Nailed bearing tree signs above blaze and land survey monument signs on back of each tree.

Painted blazes red and a 6" red band above blaze on both trees.

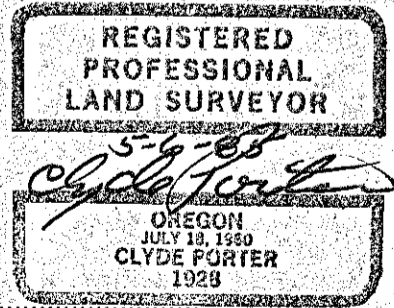

Office of..... County of.....
State of..... I hereby certify that the within instrument was filed in this office
for record on the..... day of....., 19....
..... by

(COUNTY OFFICIAL)

(DEPUTY)

FILED 5-9-86
BAKER COUNTY SURVEYOR
SURVEY NO. 7-43-100