


CERTIFIED RECORD OF LAND CORNER MONUMENTATION

History of original corner establishment:

Original survey executed by W. B. Barr in 1881 under Contract No. 388, dated May 7, 1881.

Set basalt rock 16" x 12" x 10" from which:

- 30" Tamarack bears N85W 20 lks
- 30" Fir bears S70E 131 lks

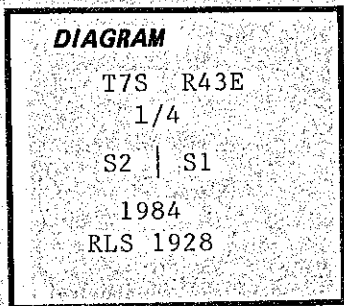

Description of corner evidence found:

Found 30" Tamarack rotten stump N85W 13.2 ft. with "BT" scribe on lower blaze and 30" Fir rotten stump S70E 86.5 ft. with no scribes visible. Both with 54-4 and 54-3 signs attached.

Found 16"x12"x10" rock lying loose with faint "1/4" scribed on face.

Description of monument and accessories established to perpetuate the original location of this corner:

Set 30" long aluminum pipe with 3 1/4" aluminum cap 12" above ground, marked as shown above. Buried old monument alongside aluminum cap.

Set steel post with signs 54-4 attached.


Scribed:

- 6" Tamarack N56E 15.7' "1/4 S1 BT"
- 11" Fir N27W 53.0' "1/4 S2 BT"

Nailed aluminum washers stamped "RLS 1928" above "BT" scribe on trees.

Painted blazes red and a 6" red band around trees.

Attached bearing tree signs above blazes and land survey monument signs to back of trees.

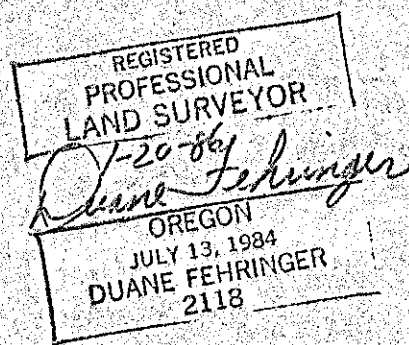

Office of..... County of.....

State of..... I hereby certify that the within instrument was filed in this office

for record on the..... day of....., 19.....

..... by..... (COUNTY OFFICIAL) (DEPUTY)

FILED 5-9-86
 BAKER COUNTY SURVEYOR
 SURVEY NO. 7-43-107