


CERTIFIED RECORD OF LAND CORNER MONUMENTATION

History of original corner establishment:

Original survey executed by W. B. Barr in 1881 under Contract No. 388, dated May 7, 1881.

Set basalt rock 12"x6"x6" from which:

- 24" pine bears S.30°E. 26 lks
- 20" pine bears S.52°W. 16 lks
- 30" fir bears N.55°E. 80 lks
- 14" pine bears N.18°W. 30 lks

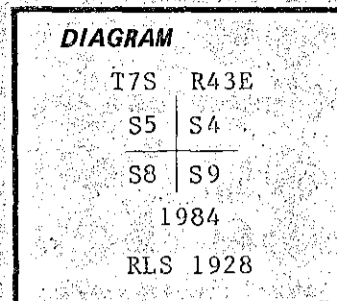

Description of corner evidence found:

Found:

- 25" pine S.52°W. 10.6' with 54-3 & 54-4 tags attached.
- Fallen pine S.30°E. 17.2' with 54-3 & 54-4 tags attached.
- 22" pine N.18°W. 19.8' with 54-3 & 54-4 tags attached.

Description of monument and accessories I established to perpetuate the original location of this corner:

Set 30" aluminum pipe with 3 1/4" aluminum cap, marked as shown above, 12" above ground mounded with rock. Steel post with 54-9 sign set next to cap.

Scribed:

- 10" spruce N.36°E 49.5' "T7S R43E S4 BT"
- 11" fir S.47°E. 21.7' "T7S R43E S9 BT"

Attached signs 54-3 & 54-9 and nailed aluminum washers stamped "RLS 1928" by "BT" scribe on each new tree. Painted blazes red and a 6" red band around all trees.



Office of..... County of.....  
 State of....., I hereby certify that the within instrument was filed in this office  
 for record on the..... day of....., 19.....  
 ..... by .....  
 (COUNTY OFFICIAL) (DEPUTY)

FILED 5-9-86  
 BAKER COUNTY SURVEYOR  
 SURVEY NO. 7-43-108