

CERTIFIED RECORD OF LAND CORNER MONUMENTATION


History of original corner establishment:

Original survey executed by W. B. Barr in 1881 under Contract No. 388, dated May 7, 1881.

Set stake 4' long 4" diameter 18" in ground from which:

10" tamarack bears N.82°E. 24 lks

4" fir bears S.10°E. 16 lks

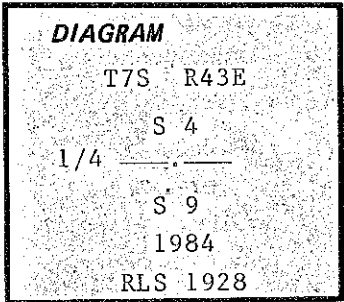

Description of corner evidence found:

NONE

Description of monument and accessories I established to perpetuate the original location of this corner:

Set 30" aluminum pipe with 3 1/4" aluminum cap, marked as shown above, 6" above ground. Steel post with sign 54-9 set next to cap.

Scribed:

6" Fir South 5.4' "1/4 S9 BT"

7" Tamarack N.50°W. 34.1' "1/4 S4 BT"

Attached signs 54-3 & 54-9 and nailed aluminum washers stamped "RLS 1928" by "BT" scribe on each tree. Painted blazes red and a 6" red band around both trees.

REGISTERED  
PROFESSIONAL  
LAND SURVEYOR  
1-20-86  
*Duane Fehring*  
OREGON  
JULY 13, 1984  
DUANE FEHRINGER  
2118

Office of..... County of.....  
State of..... I hereby certify that the within instrument was filed in this office  
for record on the..... day of....., 19.....

(COUNTY OFFICIAL)

(DEPUTY)

FILED 5-9-86  
BAKER COUNTY SURVEYOR  
SURVEY NO. 7-43-109