

CERTIFIED RECORD OF LAND CORNER MONUMENTATION


History of original corner establishment:

Original corner established in 1881 by W. B. Barr under Contract #388.

Set basalt rock 14" x 8" x 6".

Scribed:

- 36" Pine N13E 30 lks
- 20" Pine N34W 28 lks
- 12" Pine S24½W 48 lks
- 4" Pine S36½E 63 lks

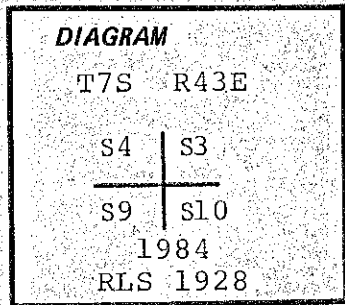

Description of corner evidence found:

No corner monument was found.

Found:

- 34" Pine in Section 4; scars grown over.
- 36" Pine in Section 9; scars grown over.
- 15" Pine in Section 10; lower scar grown over but some markings visible in upper scar.
- 36" Pine stump in Section 3; no markings visible.

Corner was set from existing bearing trees.

Description of monument and accessories I established to perpetuate the original location of this corner:

Set 30" aluminum pipe with 3¼" aluminum cap 6" above ground with rock collar. Cap marked as shown above.


Scribed:

20" Pine in Section 3 "S3 T7S R43E BT" N58E 40.0 ft.

Nailed aluminum washer stamped "RLS 1928" above "BT" scribe on tree.

Attached bearing tree signs and land survey monument signs wherever needed.

Painted all blazes red and a 6" red band above blaze on all trees.

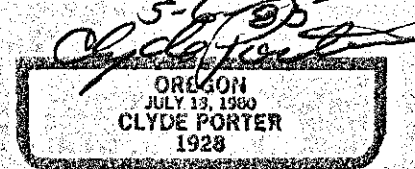

Office of..... County of.....

State of....., I hereby certify that the within instrument was filed in this office for record on the..... day of....., 19.....

(COUNTY OFFICIAL)

(DEPUTY)

FILED 5-9-86  
 BAKER COUNTY SURVEYOR  
 SURVEY NO. 7-43-110