


CERTIFIED RECORD OF LAND CORNER MONUMENTATION

History of original corner establishment:

Corner not previously established.

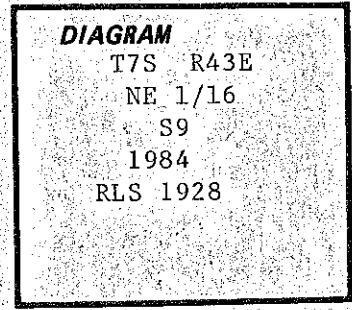

Description of corner evidence found:

Corner not previously established.

Description of monument and accessories established to perpetuate the original location of this corner:

Set 30" long aluminum pipe with 3 1/4" aluminum cap 7" above ground, marked as shown above.

Set steel post with signs 54-9 and 54-2 attached.

Scribed:

- 8" Pine "NE 1/16 S9 BT" S45W 82.2'
- 7" Pine "NE 1/16 S9 BT" N30E 31.5'

Nailed aluminum washers stamped "RLS 1928" above "BT" scribe on trees.

Painted blazes red and a 6" red band around trees.

Attached signs 54-3 & 54-9 to trees.

REGISTERED  
PROFESSIONAL  
LAND SURVEYOR

*Duane Fehringer*

OREGON  
JULY 13, 1984  
DUANE FEHRINGER  
2118

Office of..... County of.....

State of....., I hereby certify that the within instrument was filed in this office for record on the..... day of....., 19.....

..... by .....  
(COUNTY OFFICIAL) (DEPUTY)

FILED 5-9-86

BAKER COUNTY SURVEYOR

SURVEY NO. 7-43-111