


CERTIFIED RECORD OF LAND CORNER MONUMENTATION

History of original corner establishment:

Corner not previously established.

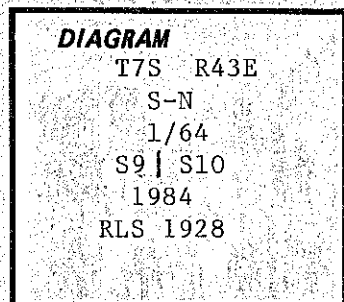

Description of corner evidence found:

Corner not previously established.

Description of monument and accessories I established to perpetuate the original location of this corner:

Set 30" long aluminum pipe with 3 1/4" aluminum cap 6" above ground, marked as shown above.

Set steel post with signs 54-9 and 54-2 attached.

Scribed:

- 8" Pine "S-N 1/64 S10 BT" N54E 45.8'
- 7" Spruce "S-N 1/64 S9 BT" S78W 35.0'
- 6" Spruce "S-N 1/64 S10 BT" N5E 38.3'

Nailed aluminum washers stamped "RLS 1928" above "BT" scribe on trees.

Painted blazes red and a 6" red band around trees.

Attached signs 54-3 & 54-9 to trees.

REGISTERED
PROFESSIONAL
LAND SURVEYOR
1-20-86
Duane Fehringer
OREGON
JULY 13, 1984
DUANE FEHRINGER
2118

Office of..... County of.....

State of....., I hereby certify that the within instrument was filed in this office

for record on the..... day of....., 19.....

..... by

(COUNTY OFFICIAL)

(DEPUTY)

FILED 5-9-86
BAKER COUNTY SURVEYOR
SURVEY NO. 7-43-116