

CERTIFIED RECORD OF LAND CORNER MONUMENTATION


History of original corner establishment:

Original survey executed by W. B. Barr in 1881 under Contract No. 388, dated May 7, 1881.

Set stake 4' long 4" diameter 18" in ground from which:

- 48" pine bears S.23°E. 125 lks
- 5" pine bears N.41½°W. 106 lks

DIAGRAM

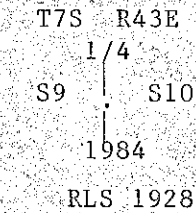

Description of corner evidence found:

Found 1½" iron pipe and a 39" pine N.41½°W. 70.0' cut out with "S" legible and 54-3 tag attached.


Description of monument and accessories I established to perpetuate the original location of this corner:

Set a 30" long aluminum pipe with 3¼" aluminum cap marked as shown above, 6" above ground. Steel post with 54-9 sign set next to cap. **BURIED 1½" (RCL)**
PIPE NEXT TO CAP

Scribed:

10" pine "1/4 S10 BT" S.29°E. 37.0'

Attached signs 54-3 and 54-9 and nailed aluminum washers stamped "RLS 1928" by "BT" scribe on new tree. Painted blazes red and a 6" red band around trees.

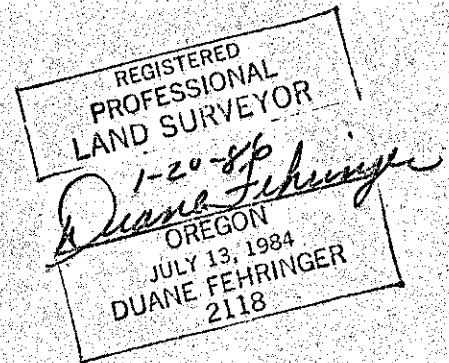

Office of..... County of.....
State of....., I hereby certify that the within instrument was filed in this office
for record on the..... day of....., 19.....

(COUNTY OFFICIAL)

(DEPUTY)

FILED 5-9-86
BAKER COUNTY SURVEYOR
SURVEY NO. 7-43-121