


CERTIFIED RECORD OF LAND CORNER MONUMENTATION

History of original corner establishment:

Corner not previously established.

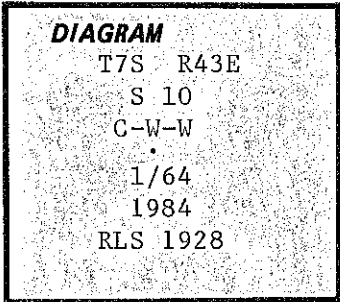

Description of corner evidence found:

Corner not previously established.

Description of monument and accessories established to perpetuate the original location of this corner:

Set 30" long aluminum pipe with 3 1/4" aluminum cap 10" above ground in a mound of rock, marked as shown above.

Set steel post with signs 54-9 and 54-2 attached 3' south of cap.


Scribed:

- 9" Pine "C-W-W 1/64 S10 BT" N40E 11.2'
- 6" Pine "C-W-W 1/64 S10 BT" S11E 24.5'

Nailed aluminum washers stamped "RLS 1928" above "BT" scribe on trees.

Painted blazes red and a 6" red band around trees.

Attached signs 54-3 & 54-9 to trees.

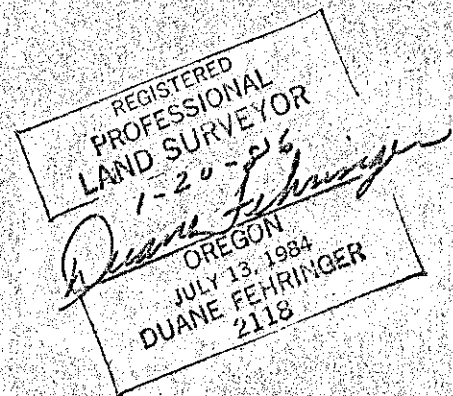

Office of..... County of.....

State of....., I hereby certify that the within instrument was filed in this office for record on the..... day of....., 19....

..... by

(COUNTY OFFICIAL)

(DEPUTY)

FILED 5-9-86
BAKER COUNTY SURVEYOR
SURVEY NO. 743-122