


CERTIFIED RECORD OF LAND CORNER MONUMENTATION

History of original corner establishment:

Original survey executed by B. W. Barr in 1881 under Contract No. 388, dated May 7, 1881.
Set Basalt rock 12"x12"x6" from which:
34" pine bears S.85½°E. 42 lks
12" fir bears S.9½°W. 49 lks

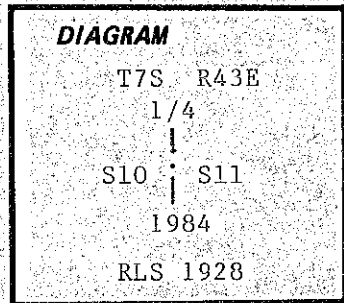

Description of corner evidence found:

Found 40" pine S.85½°E. 27.72' with scar and possible scribing visible.


Description of monument and accessories I established to perpetuate the original location of this corner:

Set 30" aluminum pipe with 3½" aluminum cap, marked as shown above, in mound of rock 24" above ground. Steel post with 54-9 sign set next to cap.

Scribed:

- 7" pine S50E 28.7' "1/4 S11 BT"
- 8" pine N03W 65.7' "1/4 S10 BT"

Attached 54-3 & 54-9 signs to both trees and nailed aluminum washers stamped "RLS 1928" by "BT" scribe on new trees. Painted blazes and a 6" red band around both trees.

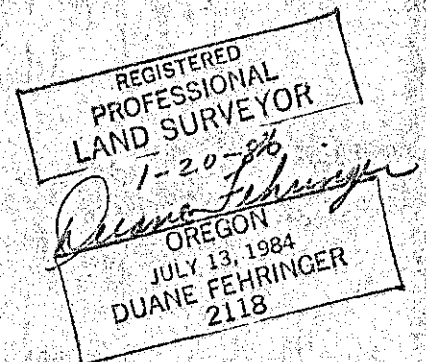

Office of..... County of.....
 State of....., I hereby certify that the within instrument was filed in this office
 for record on the..... day of....., 19....
 by
 (COUNTY OFFICIAL) (DEPUTY)