


CERTIFIED RECORD OF LAND CORNER MONUMENTATION

History of original corner establishment:

Corner not previously established.

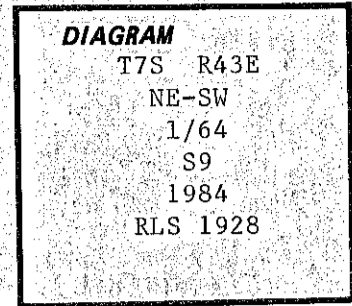

Description of corner evidence found:

Corner not previously established.

Description of monument and accessories I established to perpetuate the original location of this corner:

Set 30" long aluminum pipe with 3 1/4" aluminum cap 8" above ground, marked as shown above.

Set steel post with signs 54-9 and 54-2 attached.

Scribed:

7" Fir "NE-SW 1/64 S9 BT" S68W 6.2'
 8" Fir "NE-SW 1/64 S9 BT" N59E 22.2'

Nailed aluminum washers stamped "RLS 1928" above "BT" scribe on trees.

Painted blazes red and a 6" red band around trees.

Attached signs 54-3 & 54-9 to trees.

REGISTERED
 PROFESSIONAL
 LAND SURVEYOR
1-29-86
Duane Fehringer
 OREGON
 JULY 13, 1984
 DUANE FEHRINGER
 2118

Office of..... County of.....
 State of..... I hereby certify that the within instrument was filed in this office
 for record on the..... day of....., 19.....
 by
 (COUNTY OFFICIAL) (DEPUTY)

FILED 5-9-86
 BAKER COUNTY SURVEYOR
 SURVEY NO. 7-43-125