


CERTIFIED RECORD OF LAND CORNER MONUMENTATION

History of original corner establishment:

Corner not previously established.

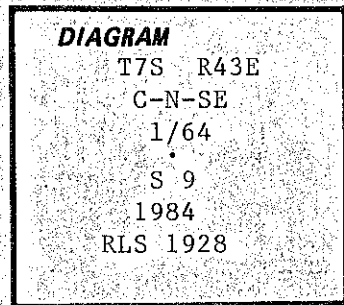

Description of corner evidence found:

Corner not previously established.

Description of monument and accessories I established to perpetuate the original location of this corner:

Set 30" long aluminum pipe with 3 1/4" aluminum cap 6" above ground, marked as shown above.

Set steel post with signs 54-9 and 54-2 attached.


Scribed:

10" Fir "C-N-SE 1/64 S9 BT" S67W 25.8'
9" Fir "C-N-SE 1/64 S9 BT" N07W 47.5'

Nailed aluminum washers stamped "RLS 1928" above "BT" scribe on trees.

Painted blazes red and a 6" red band around trees.

Attached signs 54-3 & 54-9 to trees.

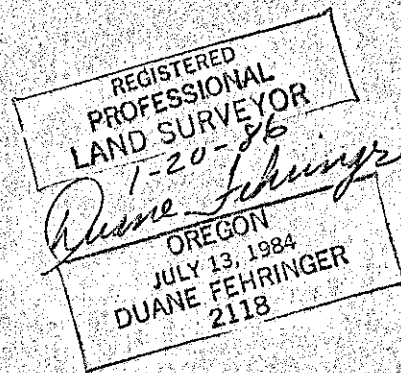

Office of..... County of.....

State of....., I hereby certify that the within instrument was filed in this office for record on the..... day of....., 19....

..... by

(COUNTY OFFICIAL)

(DEPUTY)

FILED 5-9-86
BAKER COUNTY SURVEYOR
SURVEY NO. 7-43-127