


CERTIFIED RECORD OF LAND CORNER MONUMENTATION

History of original corner establishment:

Corner not previously established.

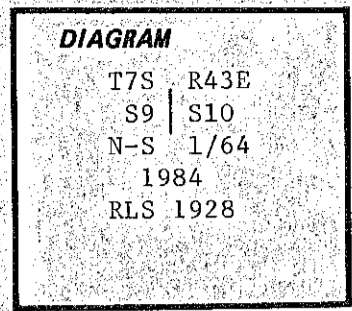

Description of corner evidence found:

Corner not previously established.

Description of monument and accessories | established to perpetuate the original location of this corner:

Set 30" long aluminum pipe with 3 1/2" aluminum cap 7" above ground, marked as shown above.

Set steel post with signs 54-9 and 54-2 attached 3' west of cap..

Scribed:

- 6" Spruce "N-S 1/64 S9 BT" N51W 24.7'
- 9" Spruce "N-S 1/64 S10 BT" S78W 13.5'

Nailed aluminum washers stamped "RLS 1928" above "BT" scribe on trees.

Painted blazes red and a 6" red band around trees.

Attached signs 54-3 & 54-9 to trees.

REGISTERED
PROFESSIONAL
LAND SURVEYOR

Duane Fehringer
1-2078p

OREGON
JULY 13, 1984
DUANE FEHRINGER
2118

Office of..... County of.....

State of....., I hereby certify that the within instrument was filed in this office for record on the..... day of....., 19.....

(COUNTY OFFICIAL)

(DEPUTY)

FILED 5-9-86

BAKER COUNTY SURVEYOR

SURVEY NO. 7-43-128