


CERTIFIED RECORD OF LAND CORNER MONUMENTATION

History of original corner establishment:

Original survey executed by W. B. Barr in 1881 under Contract No. 388, dated May 7, 1881.

Set basalt rock 18"x12"x5" from which:

- 20" pine bears S.74½°W. 64 lks
- 18" pine bears N.73°W. 10 lks
- 24" pine bears S.68°E. 30 lks
- 24" fir bears N.48°E. 19 lks

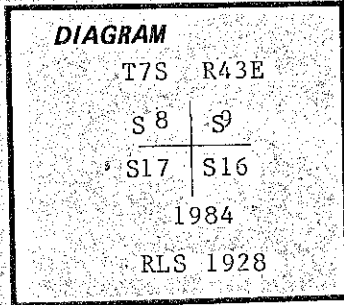

Description of corner evidence found:

Found: 18" x 12" x 5" set stone, no marks visible.

Found:

- Fallen pine N.73°W. 6.6' with scribing legible "S8" & 54-3 tag attached.
- Fallen pine S.68°E. 19.8' with scribing legible "S16" & 54-3 tag attached.
- Fallen fir N.48°E. 12.5' with 54-3 tag attached.


Description of monument and accessories | established to perpetuate the original location of this corner:

Set 30" aluminum pipe with 3¼" aluminum cap, marked as shown above, 6" above ground. Buried old monument next to cap. Steel post with 54-9 sign set next to cap.

Scribed:

- 9" Pine S.80°W. 24.6' "T7S R43E S17 BT"
- 8" pine N.50°W. 94.0' "T7S R43E S8 BT"
- 12" pine S.48°E. 43.7' "T7S R43E S16 BT"
- 14" pine N.51°E. 57.4' "T7S R43E S9 BT"

Attached 54-3 & 54-4 signs and nailed aluminum washers stamped "RLS 1928" by "BT" scribe on each new tree. Painted blazes red and a 6" red band around each tree.

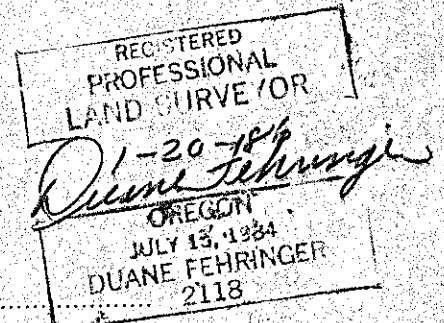

Office of..... County of.....
 State of....., I hereby certify that the within instrument was filed in this office
 for record on the..... day of....., 19.....
 by

(COUNTY OFFICIAL)

(DEPUTY)

FILED 5-9-86
 COUNTY SURVEYOR
 7-43-132