


CERTIFIED RECORD OF LAND CORNER MONUMENTATION

History of original corner establishment:

Original survey executed by W. B. Barr in 1881 under Contract No. 388, dated May 7, 1881.  
Set stake 4' long 4" diameter 18" in ground from which:  
42" pine bears S.20°W. 25 lks  
6" fir bears N.65°E. 26 lks

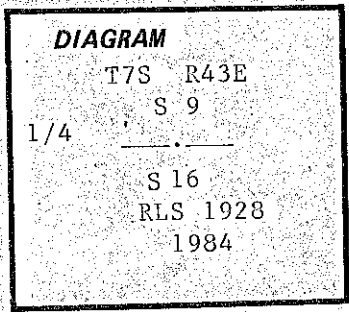

Description of corner evidence found:

42" pine S.20°W. 16.5' with open cut and 54-3 & 54-4 tags attached. No scribing visible.

Description of monument and accessories I established to perpetuate the original location of this corner:

Set 30" long aluminum pipe with 3/4" aluminum cap, marked as shown above, 6" above ground. Steel post with sign 54-9 set next to cap.

Scribed:

9" fir "S 1/4 S9 BT" N.25°E 6.0'

Attached signs 54-9 & 54-3 and nailed aluminum washer stamped "RLS 1928" by "BT" scribe on new tree. Painted blaze red and a 6" red band around both trees.

REGISTERED PROFESSIONAL LAND SURVEYOR  
1-20-86  
DUANE FEHRINGER  
OREGON  
JULY 13, 1984  
2118

Office of..... County of.....  
State of....., I hereby certify that the within instrument was filed in this office  
for record on the..... day of....., 19.....  
..... by .....  
(COUNTY OFFICIAL) (DEPUTY)

FILED 5-9-86  
BAKER COUNTY SURVEYOR  
SURVEY NO. 7-43-133