


CERTIFIED RECORD OF LAND CORNER MONUMENTATION

History of original corner establishment:

Original survey executed by W. B. Barr in 1881 under Contract No. 388, dated May 7, 1881.

Set basalt rock 12"x10"x7" form which:

- 30" fir bears N.57°E. 43 lks
- 10" pine bears S.87°E. 60 lks
- 5" pine bears S.49°W. 45 lks
- 24" pine bears N.37½°W. 107 lks

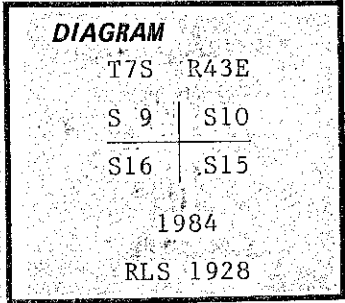

Description of corner evidence found:

Found:

Set stone 10"x7"x6" above ground with faint marking.

Found:

Stump hole N.57°E. 28.4' and stump with visible scribing laying next to corner with 54-3 tag attached.

21" pine S.87°E. 39.6' with scar and 54-3 & 54-4 tags attached.

24" pine S.49°W. 29.7' with scar and 54-3 & 54-4 tags attached.

Description of monument and accessories established to perpetuate the original location of this corner:


Set 30" aluminum pipe with a 3½" aluminum cap marked as shown above, 11" above ground mounded with rock. Buried old monument next to cap. Steel post with 54-9 sign set next to cap.

Scribed:

16" pine N.25°E. 27.5' "T7S R43E S10 BT"

12" pine N.65°W. 40.6' "T7S R43E S9 BT"

Attached signs 54-3 & 54-9 and nailed aluminum washers stamped "RLS 1928" by "BT" scribe on each new tree. Painted blazes red and a 6" red band around all trees.

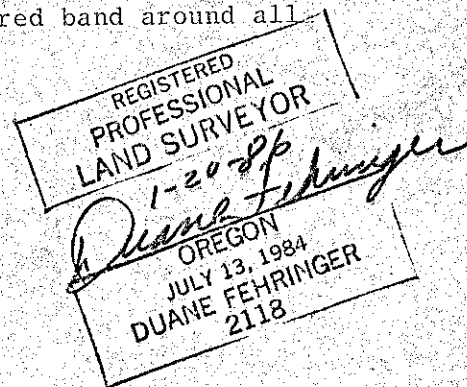

Office of..... County of.....

State of....., I hereby certify that the within instrument was filed in this office

for record on the..... day of....., 19.....

..... by
(COUNTY OFFICIAL) (DEPUTY)

FILED 5-9-86
BAKER COUNTY SURVEYOR
SURVEY NO. 7-43-134