


CERTIFIED RECORD OF LAND CORNER MONUMENTATION

History of original corner establishment:

Original survey executed by W. B. Barr in 1881 under Contract No. 388, dated May 7, 1881.

Set Basalt rock 16"x8"x8" from which:

- 24" pine bears S.28°E. 82 lks
- 5" pine bears N.57½°W. 170 lks
- 20" fir bears S.02°W. 143 lks
- 15" fir bears N.12½°E. 80 lks

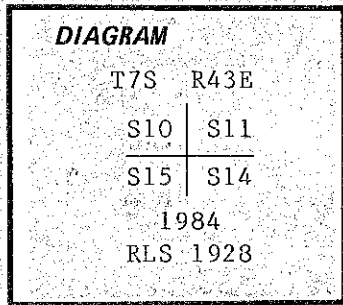

Description of corner evidence found:

Found:

- Rotten fallen stump 24" pine S.28°E., 54.12'
- Fallen 20" fir with scribing visible S.02°W., 94.38'
- Cut stump 15" fir N.12½°E., 52.80'


Description of monument and accessories I established to perpetuate the original location of this corner:

Set 30" long aluminum pipe with 3¼" aluminum cap, marked as shown above, 28" above ground mounded with rock. Steel post with 54-9 sign next to cap.

Scribed:

- 8" pine N.43°W 121.5' "T7S R43E S10 BT"
- 12" fir N.31°E. 52.3' "T7S R43E S11 BT"
- 16" pine S.12°E. 83.1' "T7S R43E S14 BT"
- 8" pine S.45W. 89.6' "T7S R43E S15 BT"

Attached signs 54-9 & 54-3 to all trees and nailed aluminum washers stamped "RLS 1928" by "BT" scribe on each new tree. Painted blazes red & a 6" red band around all trees.

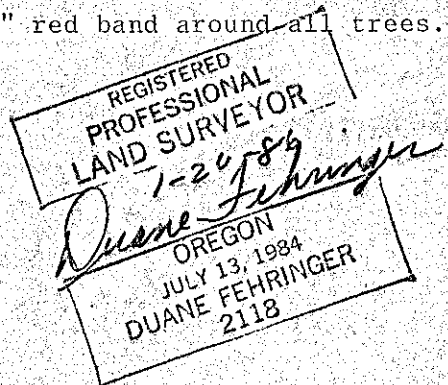

Office of..... County of.....
 State of....., I hereby certify that the within instrument was filed in this office
 for record on the..... day of....., 19.....

(COUNTY OFFICIAL)

(DEPUTY)

FILED 5-9-86
 BAKER COUNTY SURVEYOR
 SURVEY NO. 7-43-136