


CERTIFIED RECORD OF LAND CORNER MONUMENTATION

History of original corner establishment:

Original survey executed by W. B. Barr in 1881 under Contract No. 388, dated May 7, 1881.

Set basalt rock 16"x8"x8" from which:
25" pine bears N.81°E. 162 lks
80" pine bears S.47½°W. 158 lks

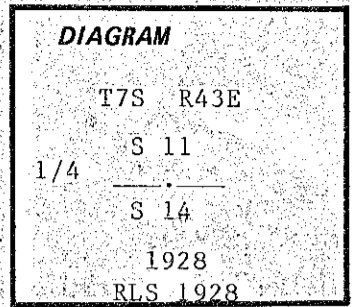

Description of corner evidence found:

Found:

- Large dead snag with scribing legible, S.38°W., 104.3'
- Large almost dead pine with scar and possible scribing, S.81°E., 106.9'

Description of monument and accessories established to perpetuate the original location of this corner:

Set 30" long aluminum pipe with 3¼" aluminum cap, marked as shown above, 30" above ground mounded with rock. Steel post with sign 54-4 mounded next to cap.

Scribed:

- 10" pine S.15°W., 137.7' "1/4 S14 BT"
- 8" fir N.46°E., 34.2' "1/4 S11 BT"

Attached signs 54-3 & 54-4 to all trees and nailed aluminum washers stamped "RLS 1928" by "BT" scribe on new trees. Painted blazes red and a 6" red band around all trees.

REGISTERED
PROFESSIONAL
LAND SURVEYOR

Duane Fehring
1-20-86
OREGON
JULY 13, 1984
DUANE FEHRINGER
2118

Office of..... County of.....
State of....., I hereby certify that the within instrument was filed in this office
for record on the..... day of....., 19.....
..... by

(COUNTY OFFICIAL)

(DEPUTY)

FILED 5-9-86
BAKER COUNTY SURVEYOR
SURVEY NO. 7-13-137