


CERTIFIED RECORD OF LAND CORNER MONUMENTATION

History of original corner establishment:

Original survey executed by W. B. Barr in 1881 under Contract No. 388, dated May 7, 1881.  
Set basalt rock 14"x7"x6" from which:  
4" pine bears S.44°E. 20 lks  
12" pine bears N.11°W. 11 lks

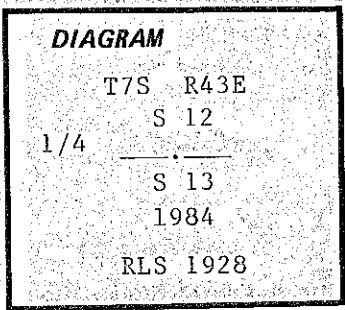

Description of corner evidence found:

Found 18" pine with "S" ledgible on top scar and "BT" ledgible on bottom scar with 54-3 tag attached, N.11°W., 7.3'

Description of monument and accessories established to perpetuate the original location of this corner:

Set 30" long aluminum pipe with 3 1/4" aluminum cap marked as shown above, 12" above ground mounded with rock. Steel post with 54-9 sign set next to cap.

Scribed:

6 1/2" spruce S.45°E. 23.7' "N 1/4 S13 BT"

Attached signs 54-9 & 54-3 and nailed aluminum washer stamped "RLS 1928" by "BT" scribed on new tree. Painted blazes red and a 6" red band around each tree.

REGISTERED  
PROFESSIONAL  
LAND SURVEYOR  
1-20-86  
*Duane Fehringer*  
OREGON  
JULY 13, 1984  
DUANE FEHRINGER  
2118

Office of..... County of.....  
State of..... I hereby certify that the within instrument was filed in this office  
for record on the..... day of....., 19.....  
..... by .....

(COUNTY OFFICIAL)

(DEPUTY)

FILED 5-9-86  
BAKER COUNTY SURVEYOR  
SURVEY NO 7-43-138