


CERTIFIED RECORD OF LAND CORNER MONUMENTATION

History of original corner establishment:

Original survey executed by W. B. Barr in 1881 under Contract No. 388, dated May 7, 1881.
Set stake 4' long 4" diameter 18" in ground from which:
3" pine bears N.82°W. 19 lks
24" pine bears N.81°E. 36 lks

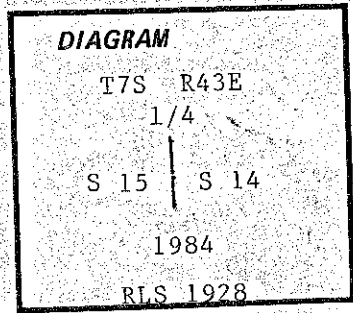

Description of corner evidence found:

Found:

39" pine with cut out area and "S" ledgible, 54-3 tag marked S.47°W 33 lks, should be marked S.81°W. 36 lks.
No other pines in area for second bearing tree.
Attached properly marked 54-3 sign to existing bearing tree.


Description of monument and accessories established to perpetuate the original location of this corner:

Set 30" aluminum pipe with 3 1/4" aluminum cap, marked as shown above, 6" above ground. Steel post with 54-9 sign set next to cap.

Scribed:

8" spruce N.29°W. 7.4' "E 1/4 S15 BT"

Attached signs 54-9 & 54-3 and nailed aluminum washer stamped "RLS 1928" by "BT" scribe on new tree. Painted blaze red and a 6" red band around trees.

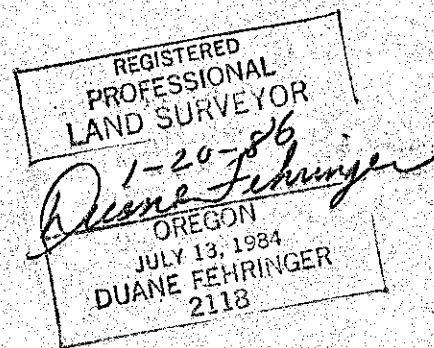

Office of..... County of.....
State of....., I hereby certify that the within instrument was filed in this office
for record on the..... day of....., 19....
..... by
(COUNTY OFFICIAL) (DEPUTY)

FILED 5-9-86
BAKER COUNTY SURVEYOR
SURVEY NO. 7-43-140