


CERTIFIED RECORD OF LAND CORNER MONUMENTATION

History of original corner establishment:

Original survey executed by W. B. Barr in 1881 under Contract No. 388, dated May 7, 1881.
Set basalt rock 12"x10"x6" from which:
10" fir bears S.73°W. 14 lks
8" fir bears S.61°E. 17 lks

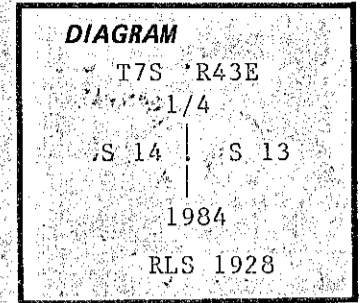

Description of corner evidence found:

Found 12"x10"x18" set stone with no scribing visible.
Found 19" fir with scars and 54-3 tag attached S.61°E. 11.2'

Description of monument and accessories I established to perpetuate the original location of this corner:

Set 30" long aluminum pipe with 3 1/4" aluminum cap marked as shown above, 8" above ground.
Buried old monument next to cap. Steel post with 54-9 sign set next to cap.

Scribed:

9" spruce N.39°W. 34.3' "E 1/4 S14 BT"

Attached signs 54-9 & 54-3 and nailed aluminum washer stamped "RLS 1928" by "BT" scribe on new tree. Painted blazes red and a 6" red band around both trees.

REGISTERED
PROFESSIONAL
LAND SURVEYOR

Duane Fehringer
1-20786
OREGON
JULY 13, 1984
DUANE FEHRINGER
2118

Office of..... County of.....

State of..... I hereby certify that the within instrument was filed in this office for record on the..... day of....., 19.....

..... by
(COUNTY OFFICIAL) (DEPUTY)

FILED 5-9-86
BAKER COUNTY SURVEYOR
SURVEY NO. 7-43-141